


NOTE
 1. EXISTING GROUND ELEVATION IS SHOWN LIGHT.
 2. FINISH GRADE ELEVATION IS SHOWN IN BOLD.

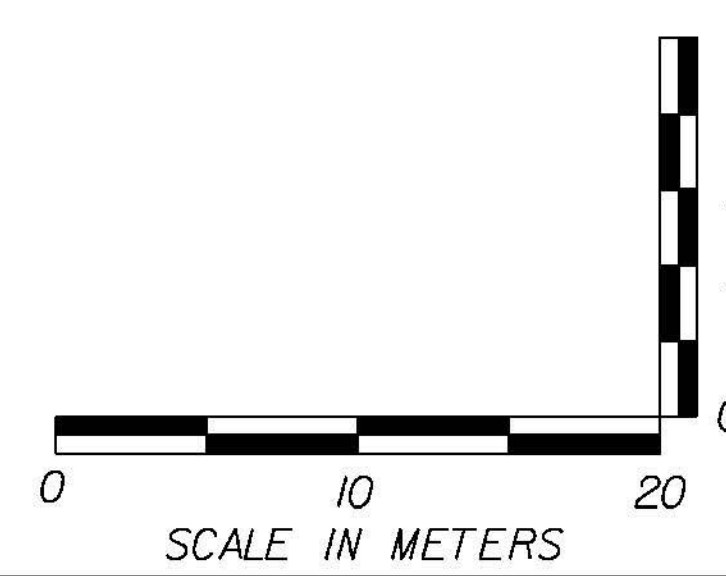

US 7 PROFILE 25

| | |
|-------------------------------|---------------------|
| PROJECT NAME: BRANDON | PLOT DATE: 9/3/2009 |
| PROJECT NUMBER: NH 019-3(495) | DRAWN BY: NLL |
| FILE NAME: zb008s5-pro25.dgn | CHECKED BY: PTS |
| PROJECT LEADER: CRB | SHEET 117 OF 546 |
| DESIGNED BY: DAM | |
| CLD 02-0149 | |