


NOTE  
1. EXISTING GROUND ELEVATION IS SHOWN LIGHT.  
2. FINISH GRADE ELEVATION IS SHOWN IN BOLD.

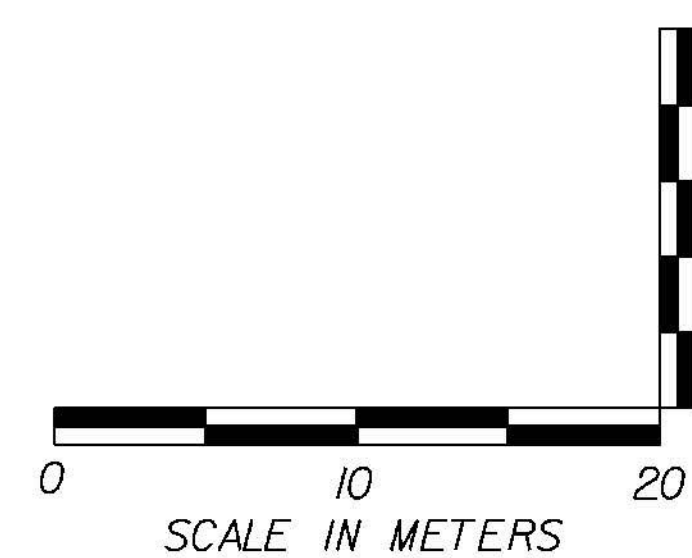

McCONNELL ROAD PROFILE

PROJECT NAME:	BRANDON	PLOT DATE:	9/3/2009
PROJECT NUMBER:	NH 019-3(495)	DRAWN BY:	NLL
FILE NAME:	zb008s5-pro29.dgn	CHECKED BY:	PTS
PROJECT LEADER:	CRB		
DESIGNED BY:	DAM		
CLD 02-0149		SHEET 124	OF 546