
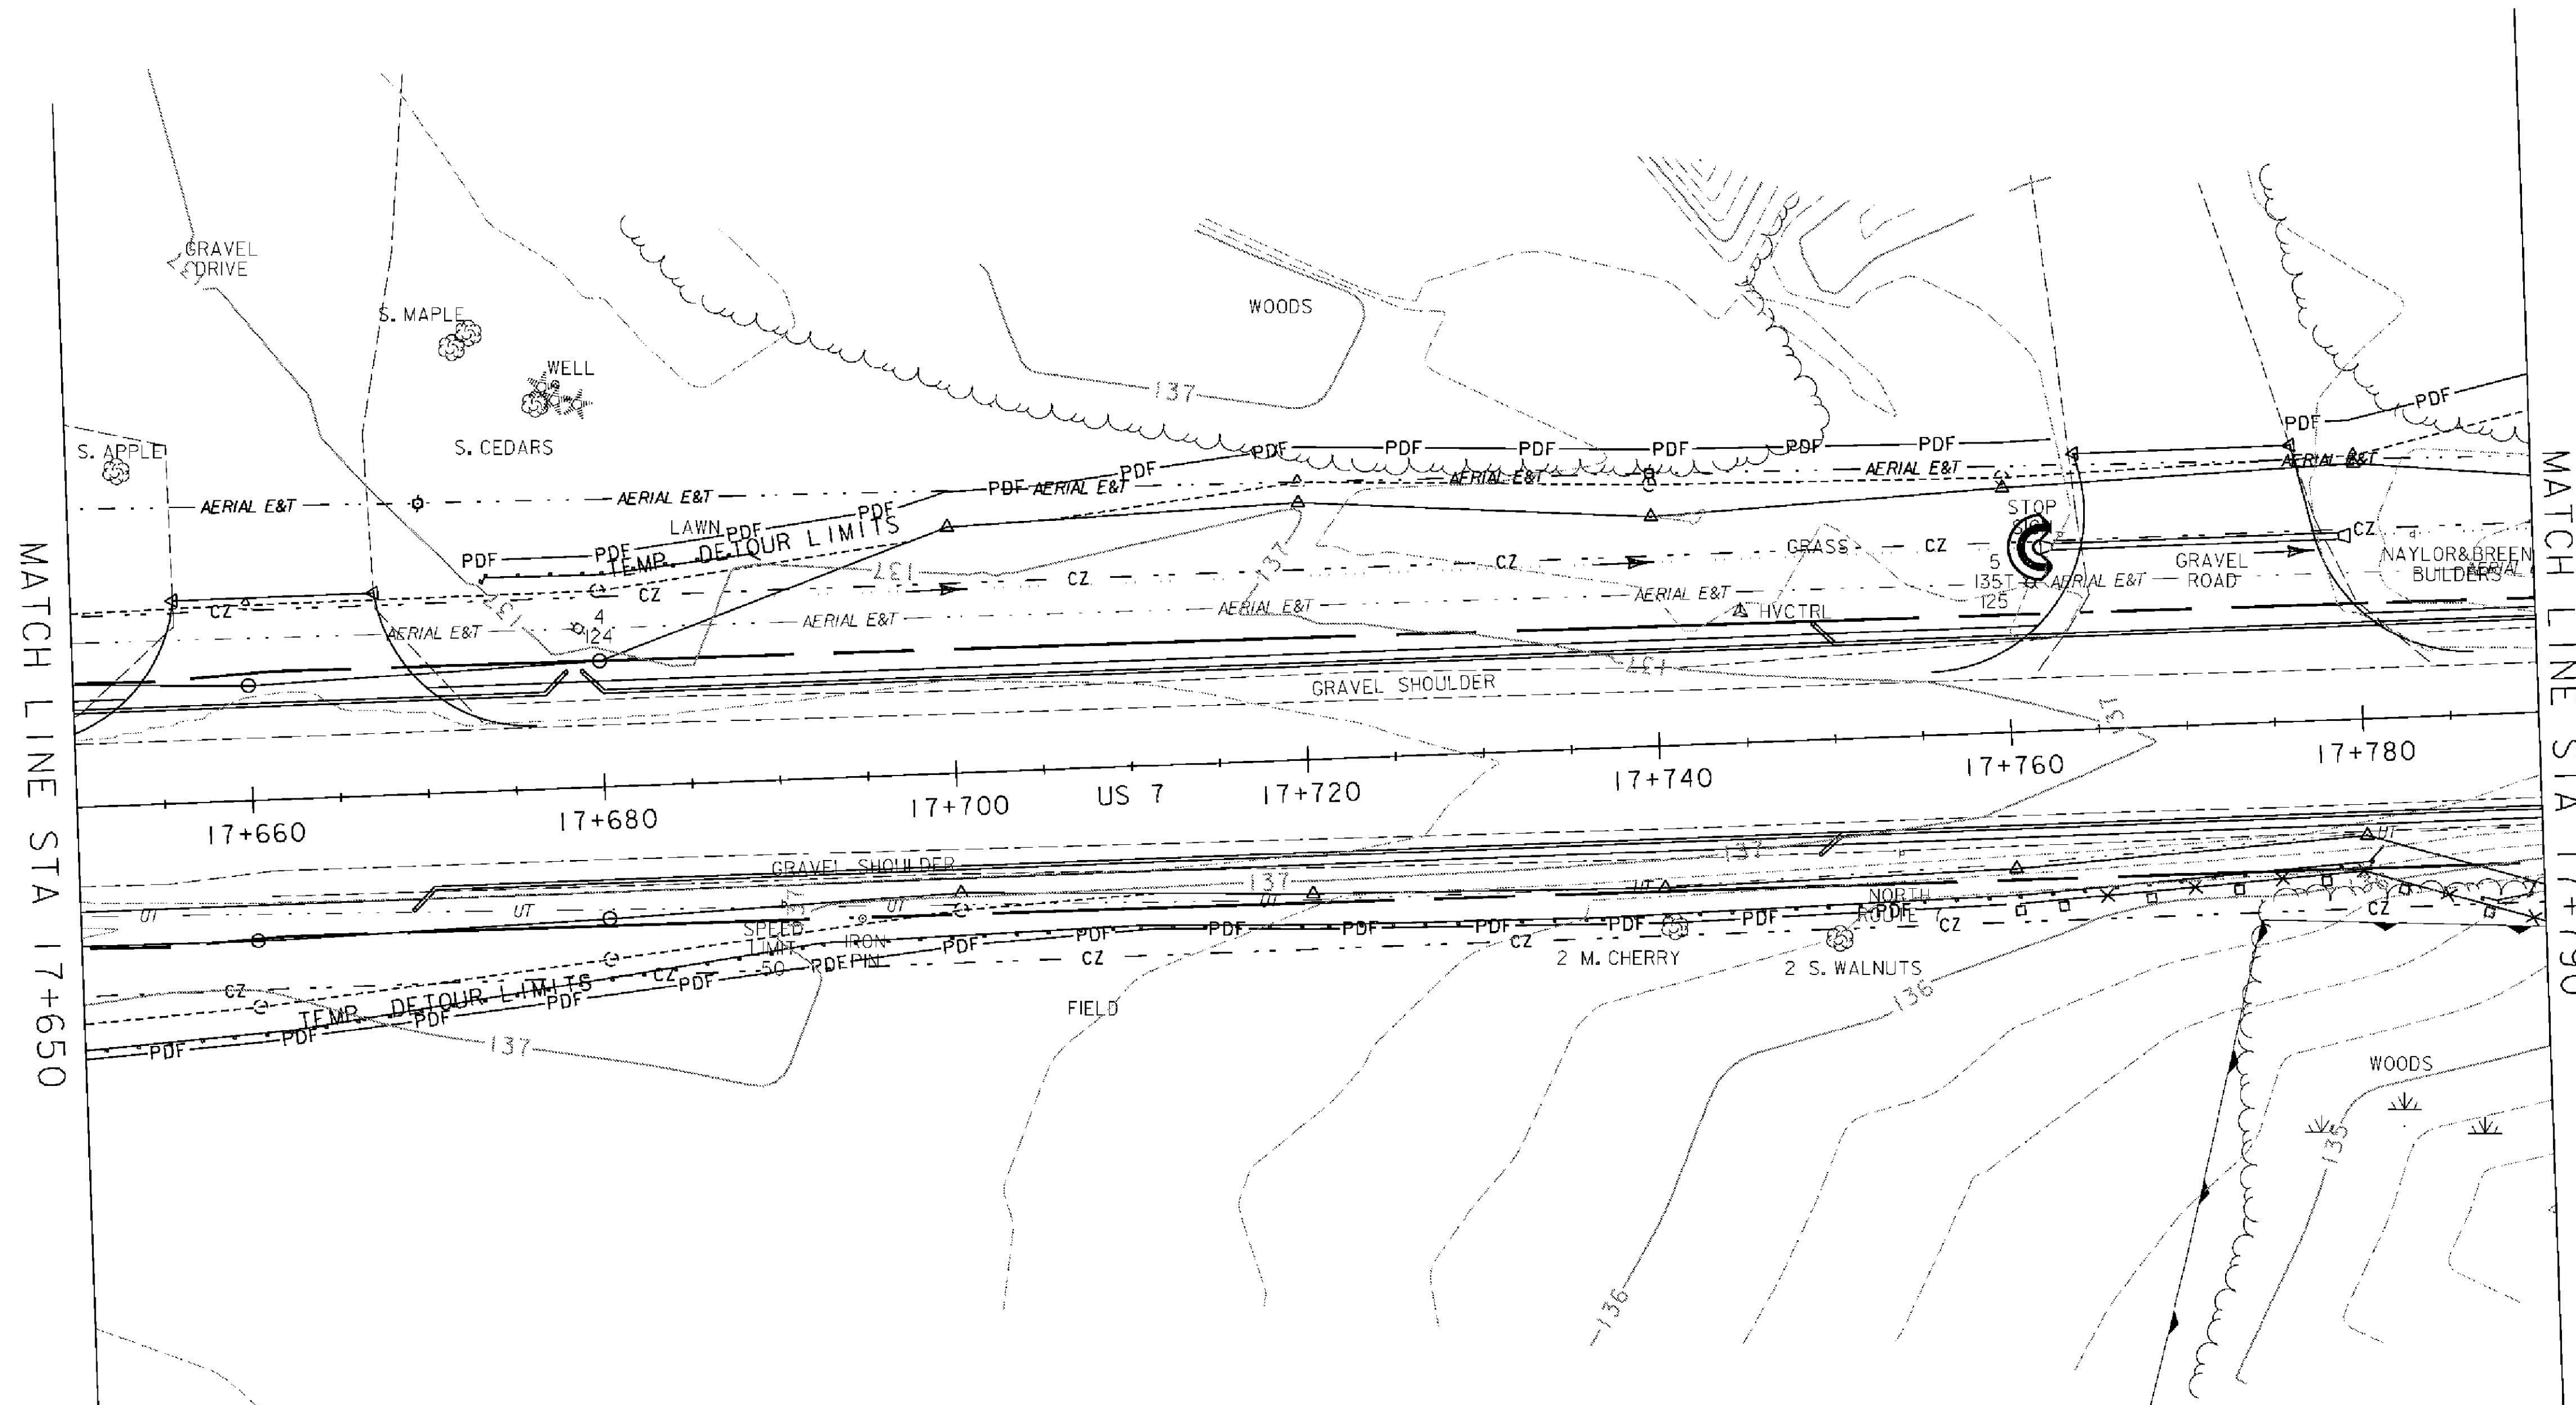


INLET PROTECTION DEVICE, TYPE I  
STA 17+760 LT

PROJECT DEMARCATION FENCE  
STA 17+650 - 17+760 RT  
STA 17+672 - 17+763 LT  
STA 17+776 - 17+790 LT  
GEOTEXTILE FOR SILT FENCE  
STA 17+650 - 17+789 RT (2)  
STA 17+673 - 17+689 LT

BARRIER FENCE  
STA 17+760 - 17+790 RT

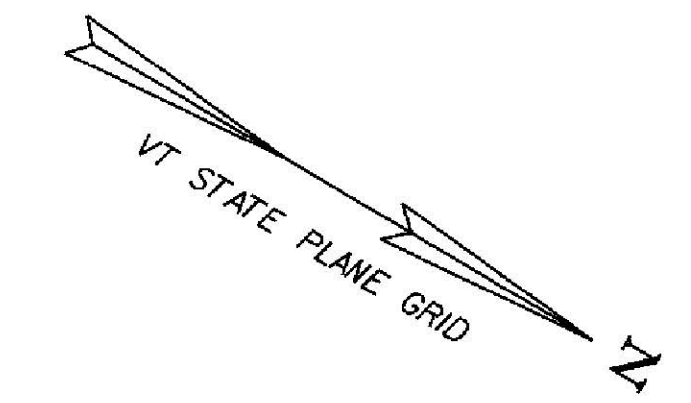

MATCH LINE STA 17+650

MATCH LINE STA 17+790

LEGEND	
	ROADSIDE DITCH/SLOPE PROTECTION
	DETOUR SLOPE LIMITS
	PERMANENT SLOPE LIMITS
	SILT FENCE
	INLET PROTECTION DEVICE, TYPE I
	PIPE INLET PROTECTION
	EROSION MATTING
	CHECK DAM - TEMPORARY
	BARRIER FENCE
	PROJECT DEMARCATION FENCE
	FILTER CURTAIN

**NOTES:**

- SILT FENCE LOCATIONS SHOWN ON THIS DRAWING ARE APPROXIMATE. THE CONTRACTOR IS RESPONSIBLE FOR INSTALLING THE SILT FENCE IN ACCORDANCE WITH THE GUIDELINES SET FORTH IN THE VERMONT GENERAL PERMIT FOR STORMWATER RUNOFF FROM CONSTRUCTION SITES. THE RESIDENT ENGINEER AND ON SITE COORDINATOR SHALL APPROVE ALL SILT FENCE LOCATIONS PRIOR TO PLACEMENT.
- FOR EROSION PREVENTION AND SEDIMENT CONTROL PLAN GENERAL NOTES, SEE SHEETS 147 - 148, AND DETAILS, SEE SHEETS 177 - 180.

**EROSION CONTROL PLAN 9**

PROJECT NAME: BRANDON	PLOT DATE: 9/3/2009
PROJECT NUMBER: NH 019-3(495)	DRAWN BY: NLL
FILE NAME: zb008s5-ec09.dgn	CHECKED BY: PTS
PROJECT LEADER: CRB	SHEET 157 OF 546
DESIGNED BY: NLL	
CLD 02-019	

