

STONE FILL, TYPE II (IN DITCHES)
 GEOTEXTILE UNDER STONE FILL
 STA 20+650 - 20+730 LT
 STA 20+735 - 20+781 RT

INLET PROTECTION DEVICE, TYPE I
 STA 20+724 RT
 STA 20+730 LT
 STA 20+755 RT
 STA 20+780 LT
 STA 20+781 RT



PROJECT DEMARCATION FENCE
 STA 20+650 - 20+778 LT
 STA 20+730 - 20+778 RT

GEOTEXTILE FOR SILT FENCE
 STA 20+739 - 20+770 LT (4)

STA 20+820.000 AHD
 END APPROACH

BM #3
 TOP OF S.E. SIGN BASE BOLT
 ELEV. = 42.979 m

STA 20+777.617 BK
 END PROJECT
 NH 019-3(495)
 BEGIN APPROACH

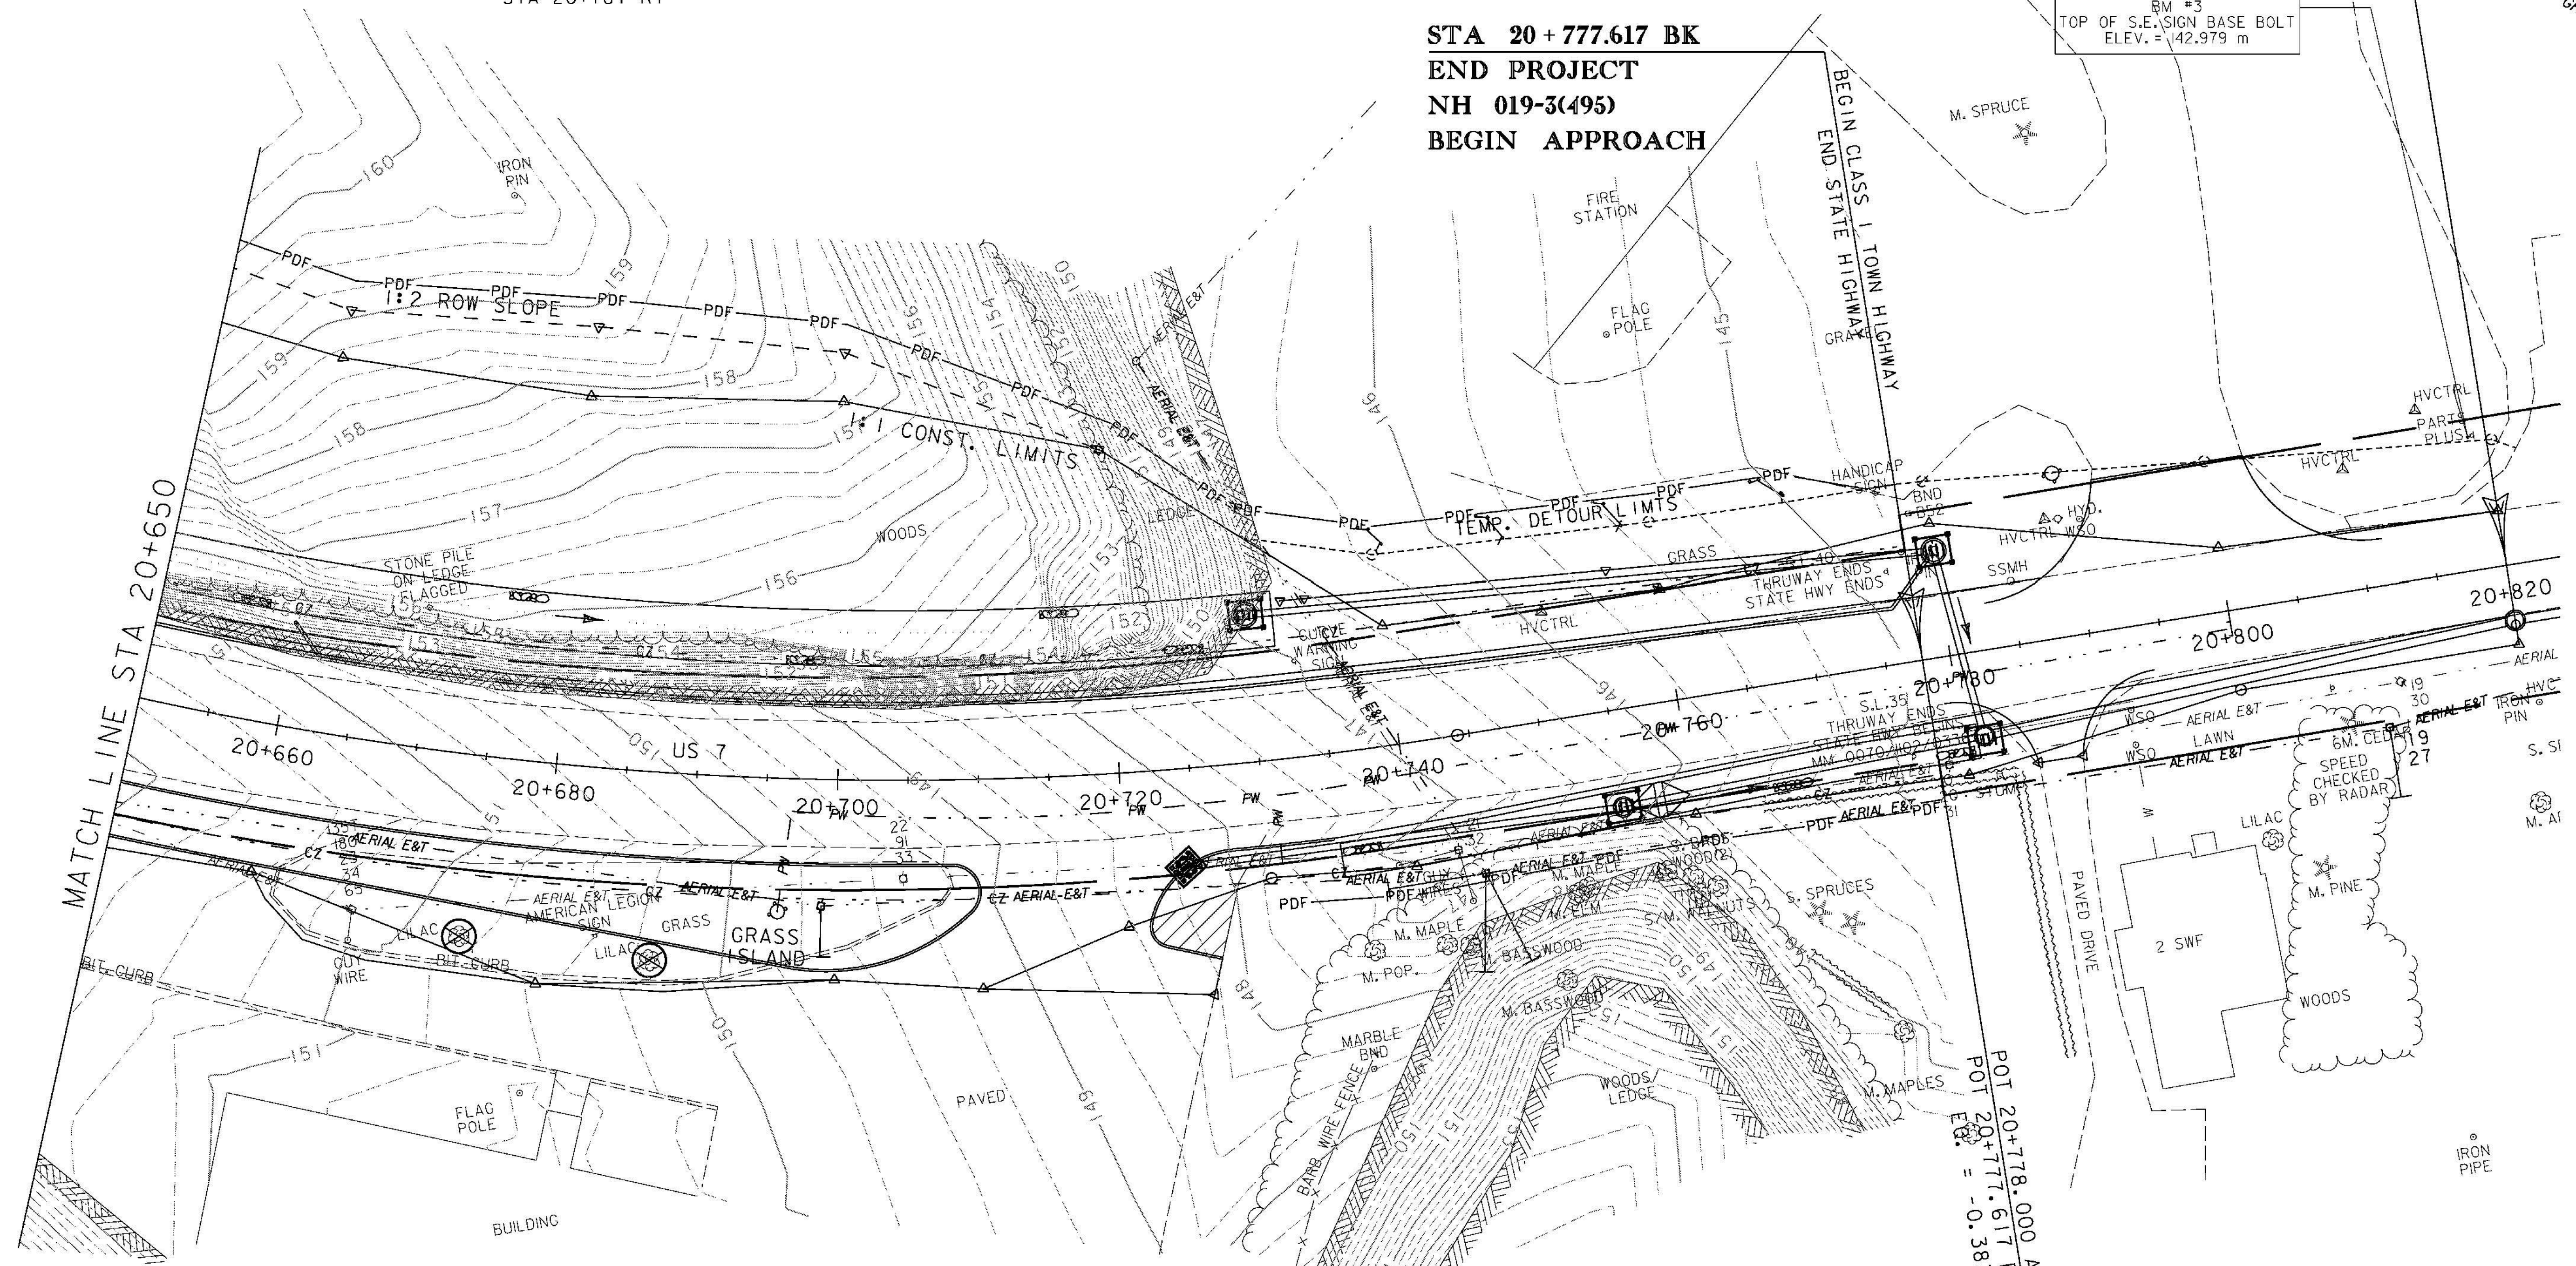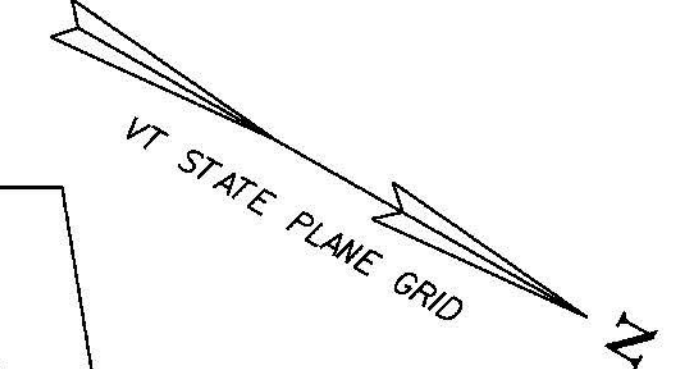

LEGEND	
	ROADSIDE DITCH/SLOPE PROTECTION
	DETOUR SLOPE LIMITS
	PERMANENT SLOPE LIMITS
	SILT FENCE
	INLET PROTECTION DEVICE, TYPE I
	PIPE INLET PROTECTION
	EROSION MATTING
	CHECK DAM - TEMPORARY
	BARRIER FENCE
	PROJECT DEMARCATION FENCE
	FILTER CURTAIN

NOTES:

1. SILT FENCE LOCATIONS SHOWN ON THIS DRAWING ARE APPROXIMATE. THE CONTRACTOR IS RESPONSIBLE FOR INSTALLING THE SILT FENCE IN ACCORDANCE WITH THE GUIDELINES SET FORTH IN THE VERMONT GENERAL PERMIT FOR STORMWATER RUNOFF FROM CONSTRUCTION SITES. THE RESIDENT ENGINEER AND ON SITE COORDINATOR SHALL APPROVE ALL SILT FENCE LOCATIONS PRIOR TO PLACEMENT.
2. FOR EROSION PREVENTION AND SEDIMENT CONTROL PLAN GENERAL NOTES, SEE SHEETS 147 - 148, AND DETAILS, SEE SHEETS 177 - 180.



EROSION CONTROL PLAN 28

PROJECT NAME: BRANDON	PLOT DATE: 9/3/2009
PROJECT NUMBER: NH 019-3(495)	DRAWN BY: NLL
FILE NAME: zb008s5-ec28.dgn	CHECKED BY: PTS
PROJECT LEADER: CRB	SHEET 176 OF 546
DESIGNED BY: NLL	
CLD 02-0149	