


MATCH LINE STA 17+010

MATCH LINE STA 17+170

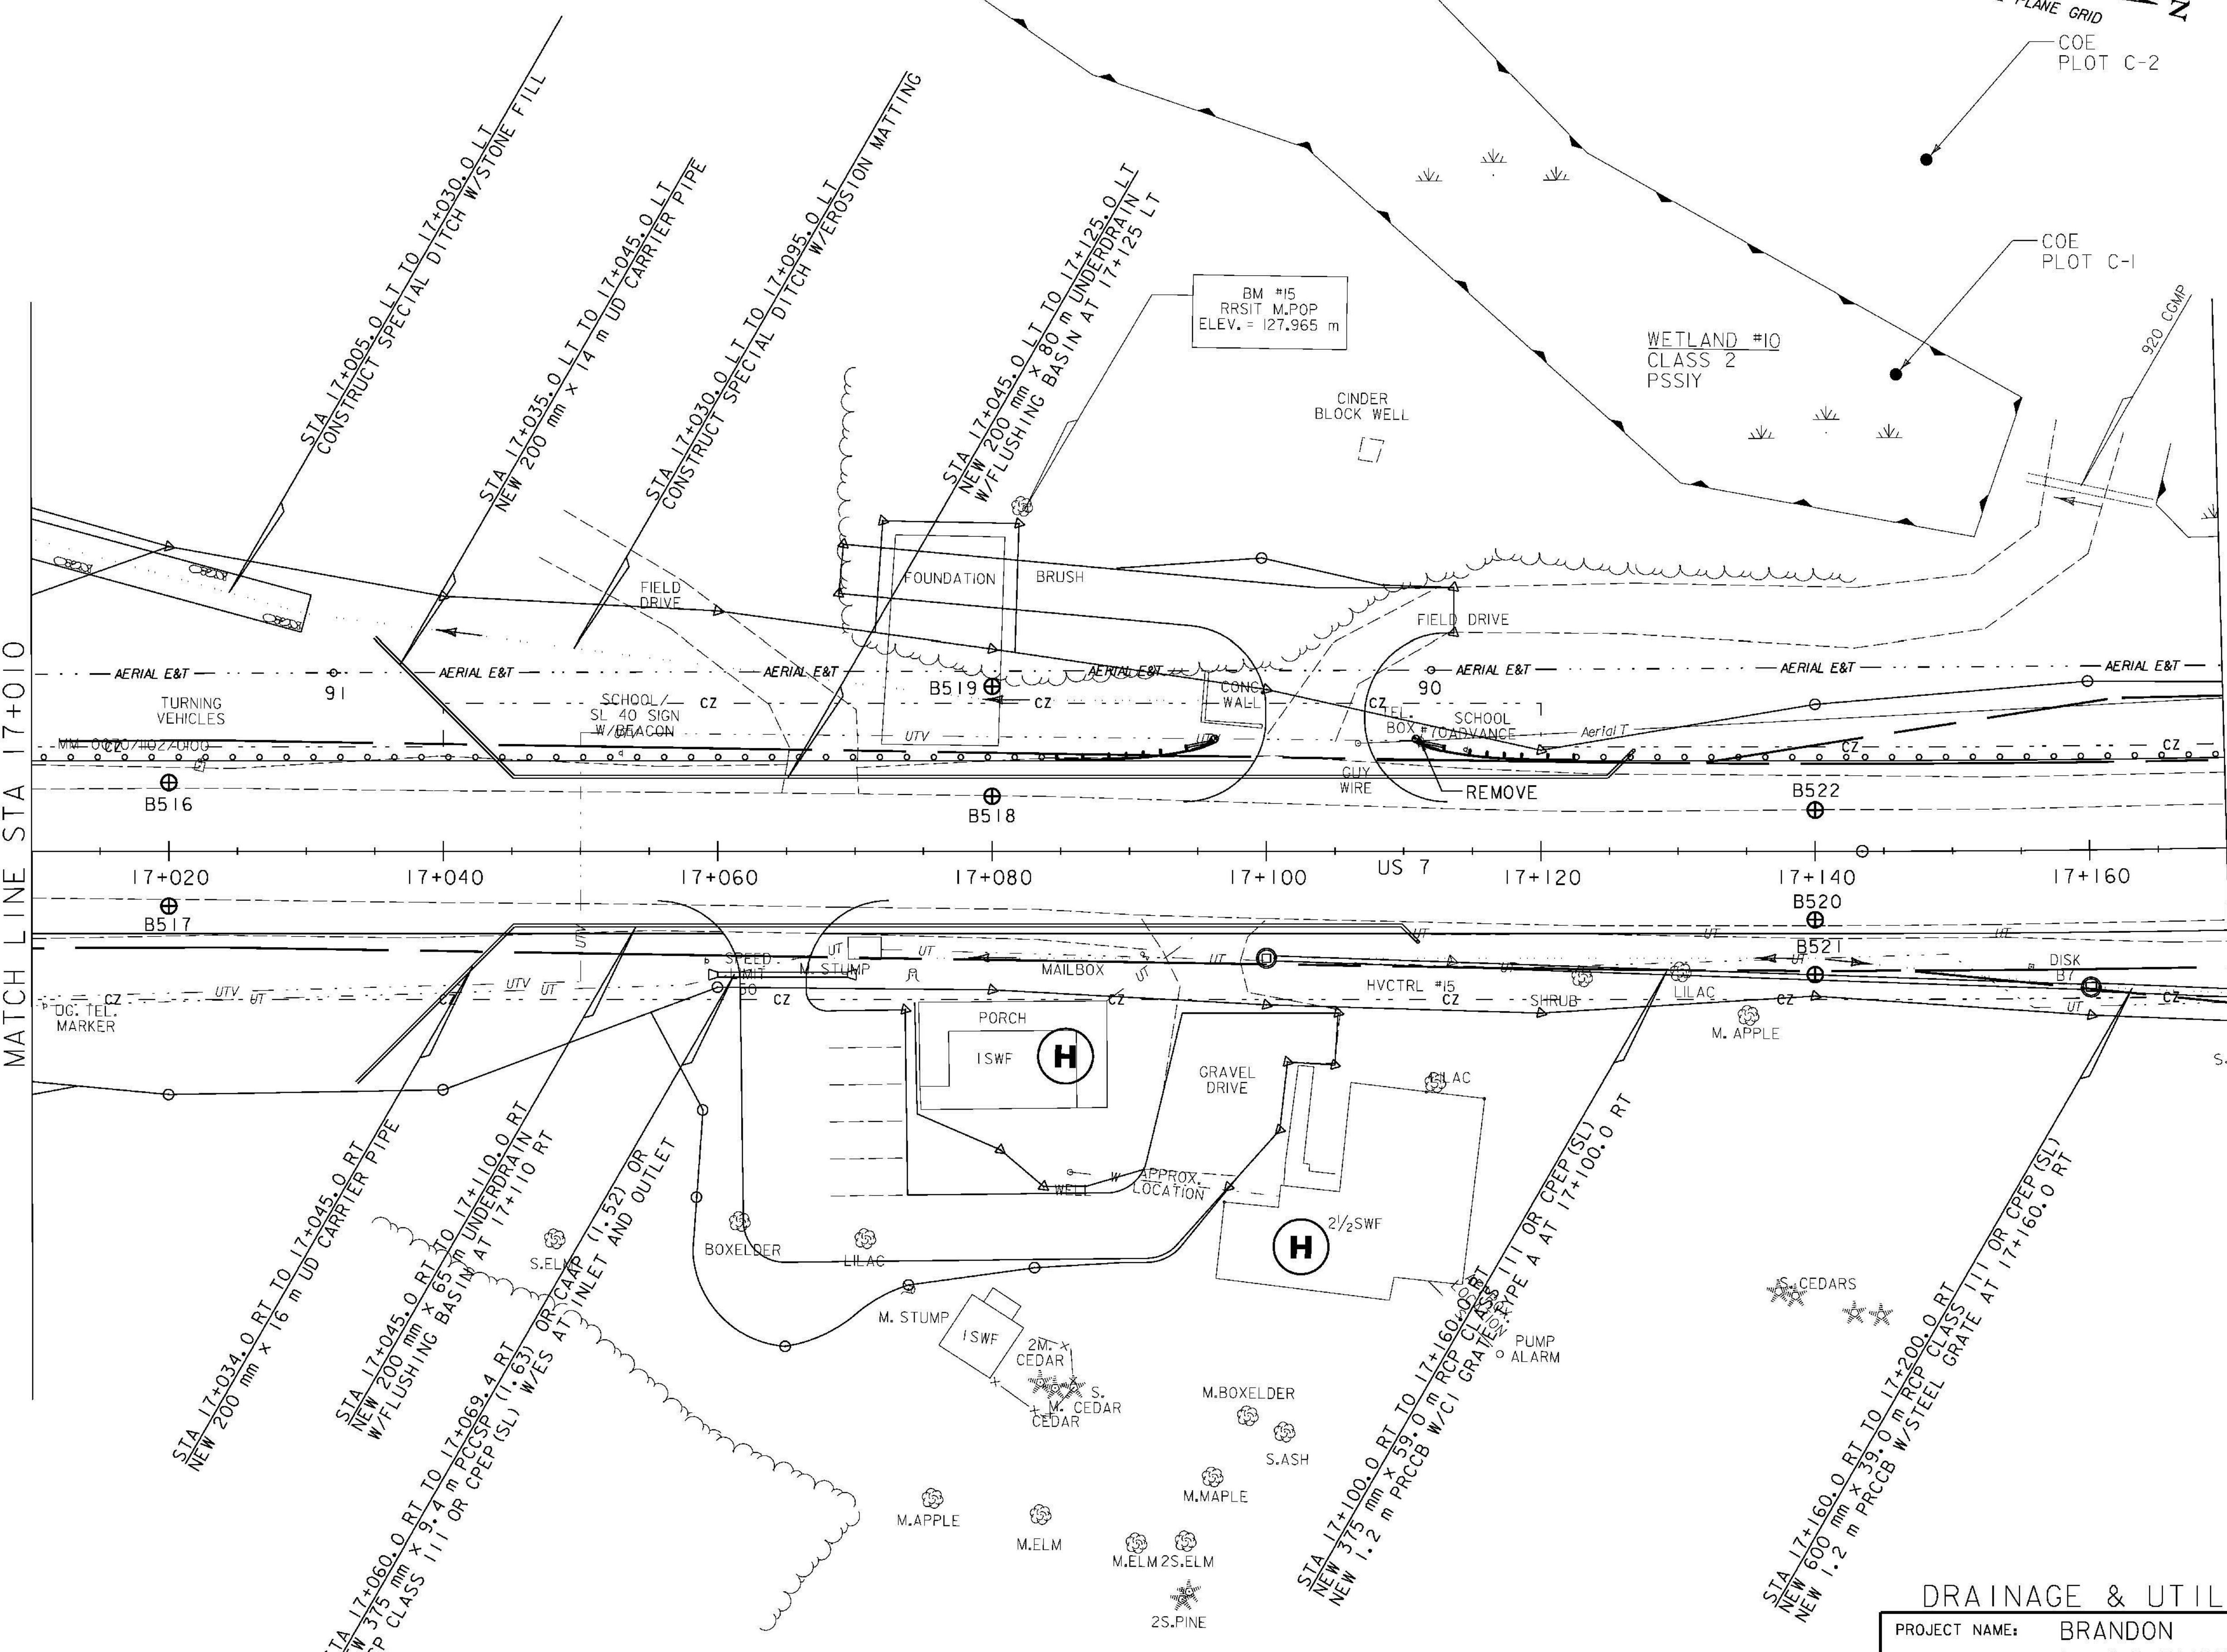

BM #15  
RRSIT M.POP  
ELEV. = 127.965 m

**DRAINAGE & UTILITY LAYOUT 5**

PROJECT NAME:	BRANDON	PLOT DATE:	9/3/2009
PROJECT NUMBER:	NH 019-3(495)	DRAWN BY:	NLL
FILE NAME:	zb008s5-drn05.dgn	CHECKED BY:	PTS
PROJECT LEADER:	CRB	SHEET	185 OF 546
DESIGNED BY:	DAM		
CLD 02-0149			

