



BM #13
RRSR S.PINE
EL. = 135.931m

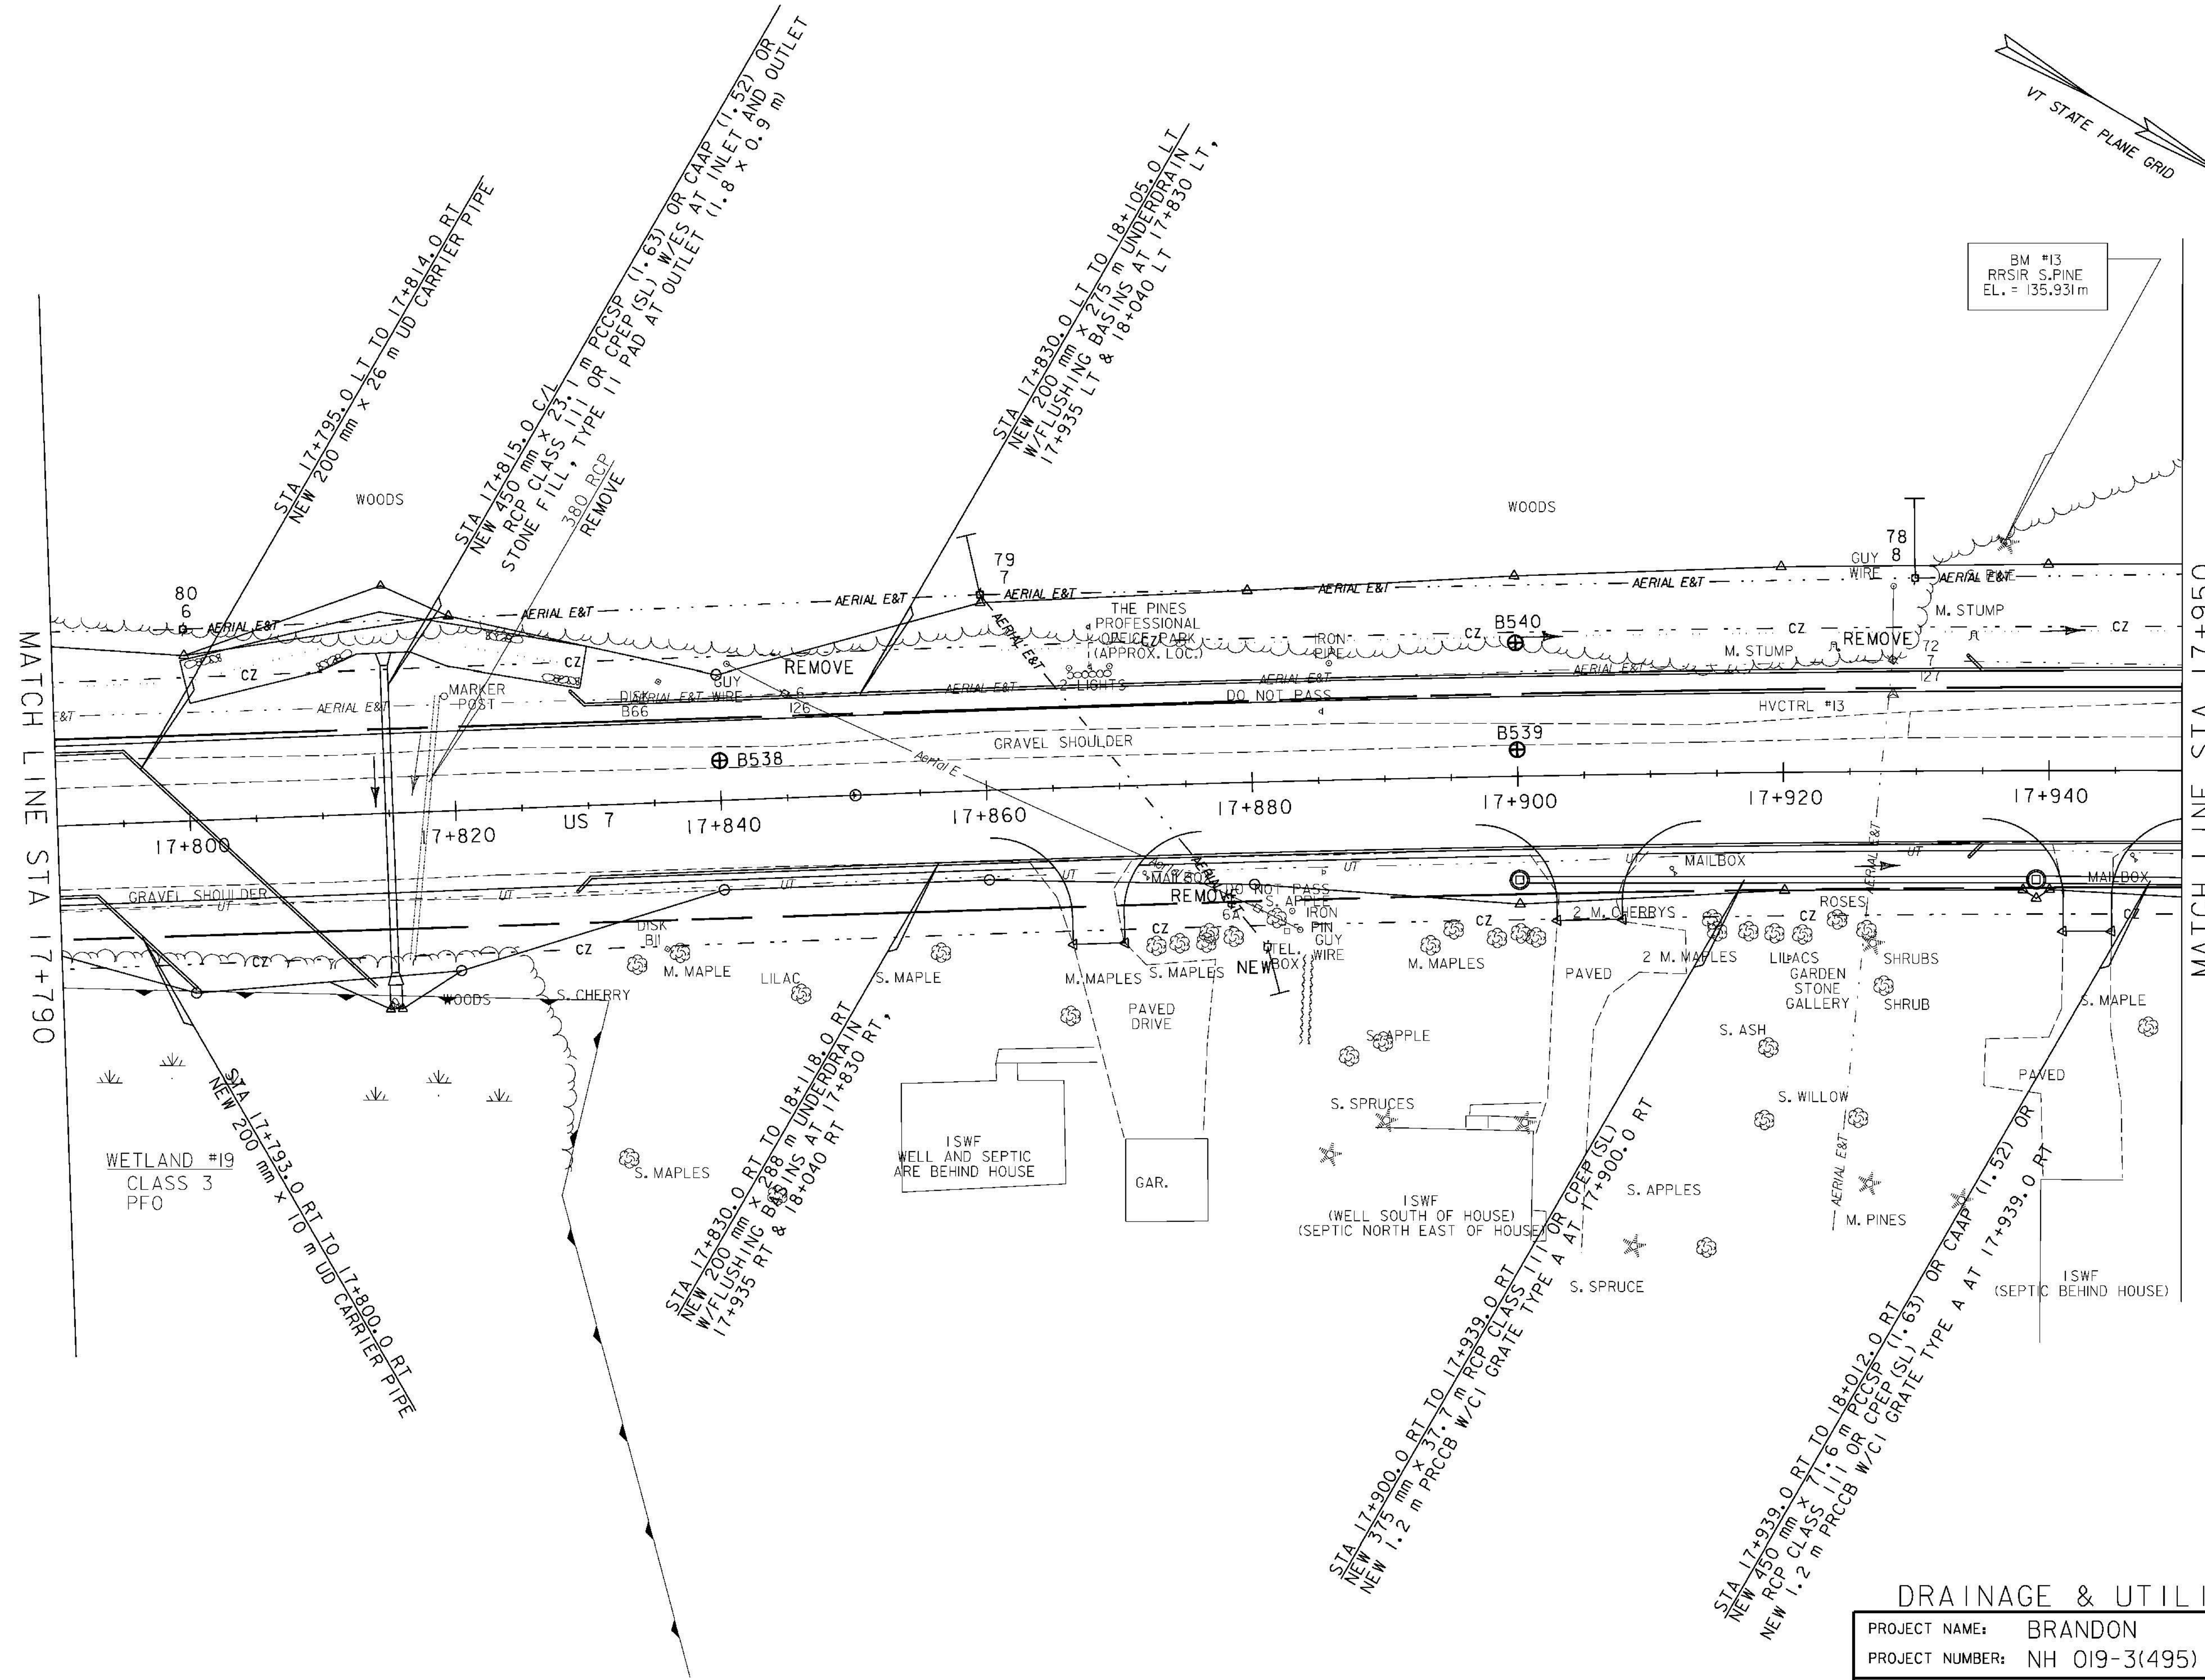

MATCH LINE STA 17+790

MATCH LINE STA 17+950

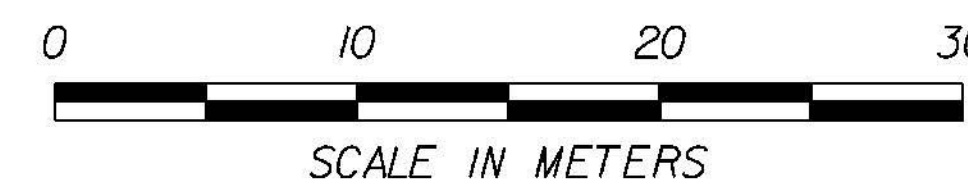

DRAINAGE & UTILITY LAYOUT 10	
PROJECT NAME:	BRANDON
PROJECT NUMBER:	NH 019-3(495)
FILE NAME:	zb008s5-drn10.dgn
PROJECT LEADER:	CRB
DESIGNED BY:	DAM
CLD 02-0149	
PLOT DATE:	9/3/2009
DRAWN BY:	NLL
CHECKED BY:	PTS
SHEET	190 OF 546