


LANDSCAPE BACKFILL, TRUCK MEASUREMENT  
 STA 17+975 TO 18+013 RT - 38 m x 3 m x 0.3 m

DECIDUOUS SHRUBS    DECIDUOUS TREES    EVERGREEN TREES  
 10 PO                    3 BP, 2 AG                    18 PG, 7 TO

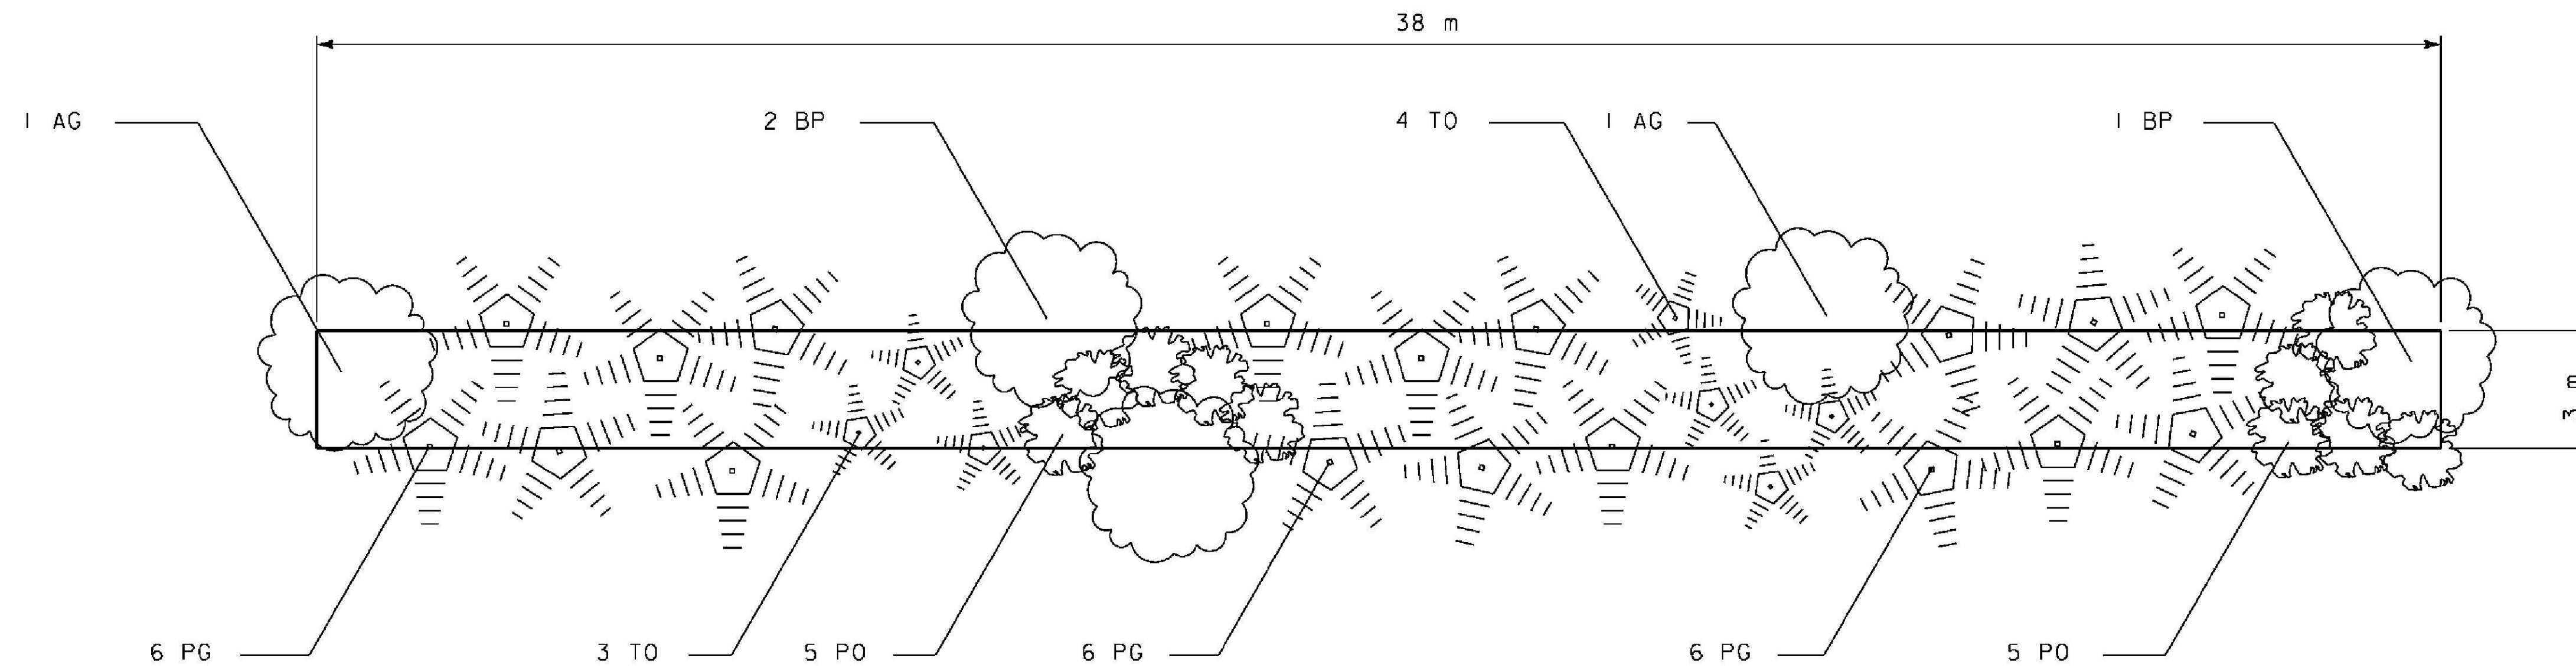

NOTE  
 1. SEE PLANT LIST FOR ADDITIONAL INFORMATION.  
 2. MULCH ENTIRE BED.

NOTE:  
 WORK NOT DONE.  
 MATTHEW PHILO SIGNED OFF ON THIS ON 09/29/10  
 AS WE ADJUSTED THE PIPE RUN IN THIS AREA  
 TO LEAVE THE EXISTING HEDGE ROW.

**STA 17+975 - 18+013 RT**  
**LANDSCAPE DETAIL**  
 (NOT TO SCALE)

**PLANT LIST**

QTY	KEY	BOTANICAL NAME	COMMON NAME	SIZE	CONTAINER	SPACING, REMARKS ITEMS#
<u>DECIDUOUS SHRUBS</u>						
ITEM No. 656.35						
87	PO	PHYSOCARPUS OPULIFOLIUS	NINEBARK	750-900 HEIGHT	CONTAINER	1330 o.c. - SPRING PLANTING
56	RR	ROSA RUGOSA	RUGOSA ROSE	750-900 HEIGHT	CONTAINER	1330 o.c. - SPRING PLANTING
206	RT	RHUS TYPHINA	STAGHORN SUMAC	750-900 HEIGHT	CONTAINER	1330 o.c. - SPRING PLANTING
34	SPA	SYRINGA PATULA 'MISS KIM'	MISS KIM DWARF LILAC	750-900 HEIGHT	CONTAINER	1330 o.c. - SPRING PLANTING
22	SP	SALIX PURPUREA	BLUE ARCTIC WILLOW	750-900 HEIGHT	CONTAINER	1330 o.c. - SPRING PLANTING
49	CR	CORNUS RACEMOSA	GRAY DOGWOOD	750-900 HEIGHT	CONTAINER	1330 o.c. - SPRING PLANTING
<u>DECIDUOUS TREES</u>						
ITEM No. 656.30						
6	MHG	MALUS 'HARVEST GOLD'	HARVEST GOLD CRABAPPLE	25-40 CAL.	B&B	AS SHOWN - SPRING PLANTING
3	BP	BETULA Papyrifera	PAPER BIRCH	2440-3050 HEIGHT-3 STEM	B&B	AS SHOWN - SPRING PLANTING
8	GT	GLEDITSIA TRIACANTHOS INERMIS 'SHADEMASTER'	SHADEMASTER HONEYLOCUST	50-65 CAL.	B&B	AS SHOWN - SPRING PLANTING
9	AF	ACER X FREEMANII 'AUTUMN BLAZE'	AUTUMN BLAZE MAPLE	50-65 CAL.	B&B	AS SHOWN - SPRING PLANTING
5	UC	ULMUS CARPINIFOLIA 'ACCOLADE'	ACCOLADE ELM	50-65 CAL.	B&B	AS SHOWN - SPRING PLANTING
2	AG	ACER GINNALA	AMUR MAPLE	25-40 CAL.	B&B	AS SHOWN - SPRING PLANTING
2	QR	QUERCUS RUBRA	RED OAK	50-65 CAL.	B&B	AS SHOWN - SPRING PLANTING
3	S. MAPLE	ACER SACCHARUM - SUGAR MAPLE (50-65 CaL)(BEB)	SUGAR MAPLE	50 - 60 CAL	B&B	
<u>EVERGREEN TREES</u>						
ITEM No. 656.20						
22	PG	PICEA GLAUCA	WHITE SPRUCE	1830-2130 HEIGHT	B&B	AS SHOWN - SPRING PLANTING
7	TO	THUJA OCCIDENTALIS	NORTHERN WHITE CEDAR	910-1220 HEIGHT	CONTAINER	AS SHOWN - SPRING PLANTING
13	CRAB	SUGAR TYME - CRAB APPLE	CRAB APPLE	25 - 40 CAL	B&B	

LANDSCAPE DETAIL SHEET 1

PROJECT NAME: BRANDON	PLOT DATE: 9/3/2009
PROJECT NUMBER: NH 019-3(495)	DRAWN BY: JCS
FILE NAME: zb008ldscDe+01-5.dgn	CHECKED BY: PTS
PROJECT LEADER: CRB	SHEET 210 OF 546
DESIGNED BY: VTRANS	
CLD 02-0149	