



DECIDUOUS SHRUBS
STA 16+506 TO 16+530 RT - 49 CR

LANDSCAPE BACKFILL, TRUCK MEASUREMENT
STA 16+506 TO 16+530 RT - 24 m x 3.7 m x 0.3 m

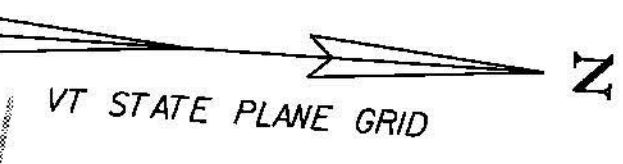

STA 16+418.474 BK
BEGIN APPROACH

STA 16+460.000 AHD
END APPROACH
BEGIN PROJECT
NH 019-3(495)

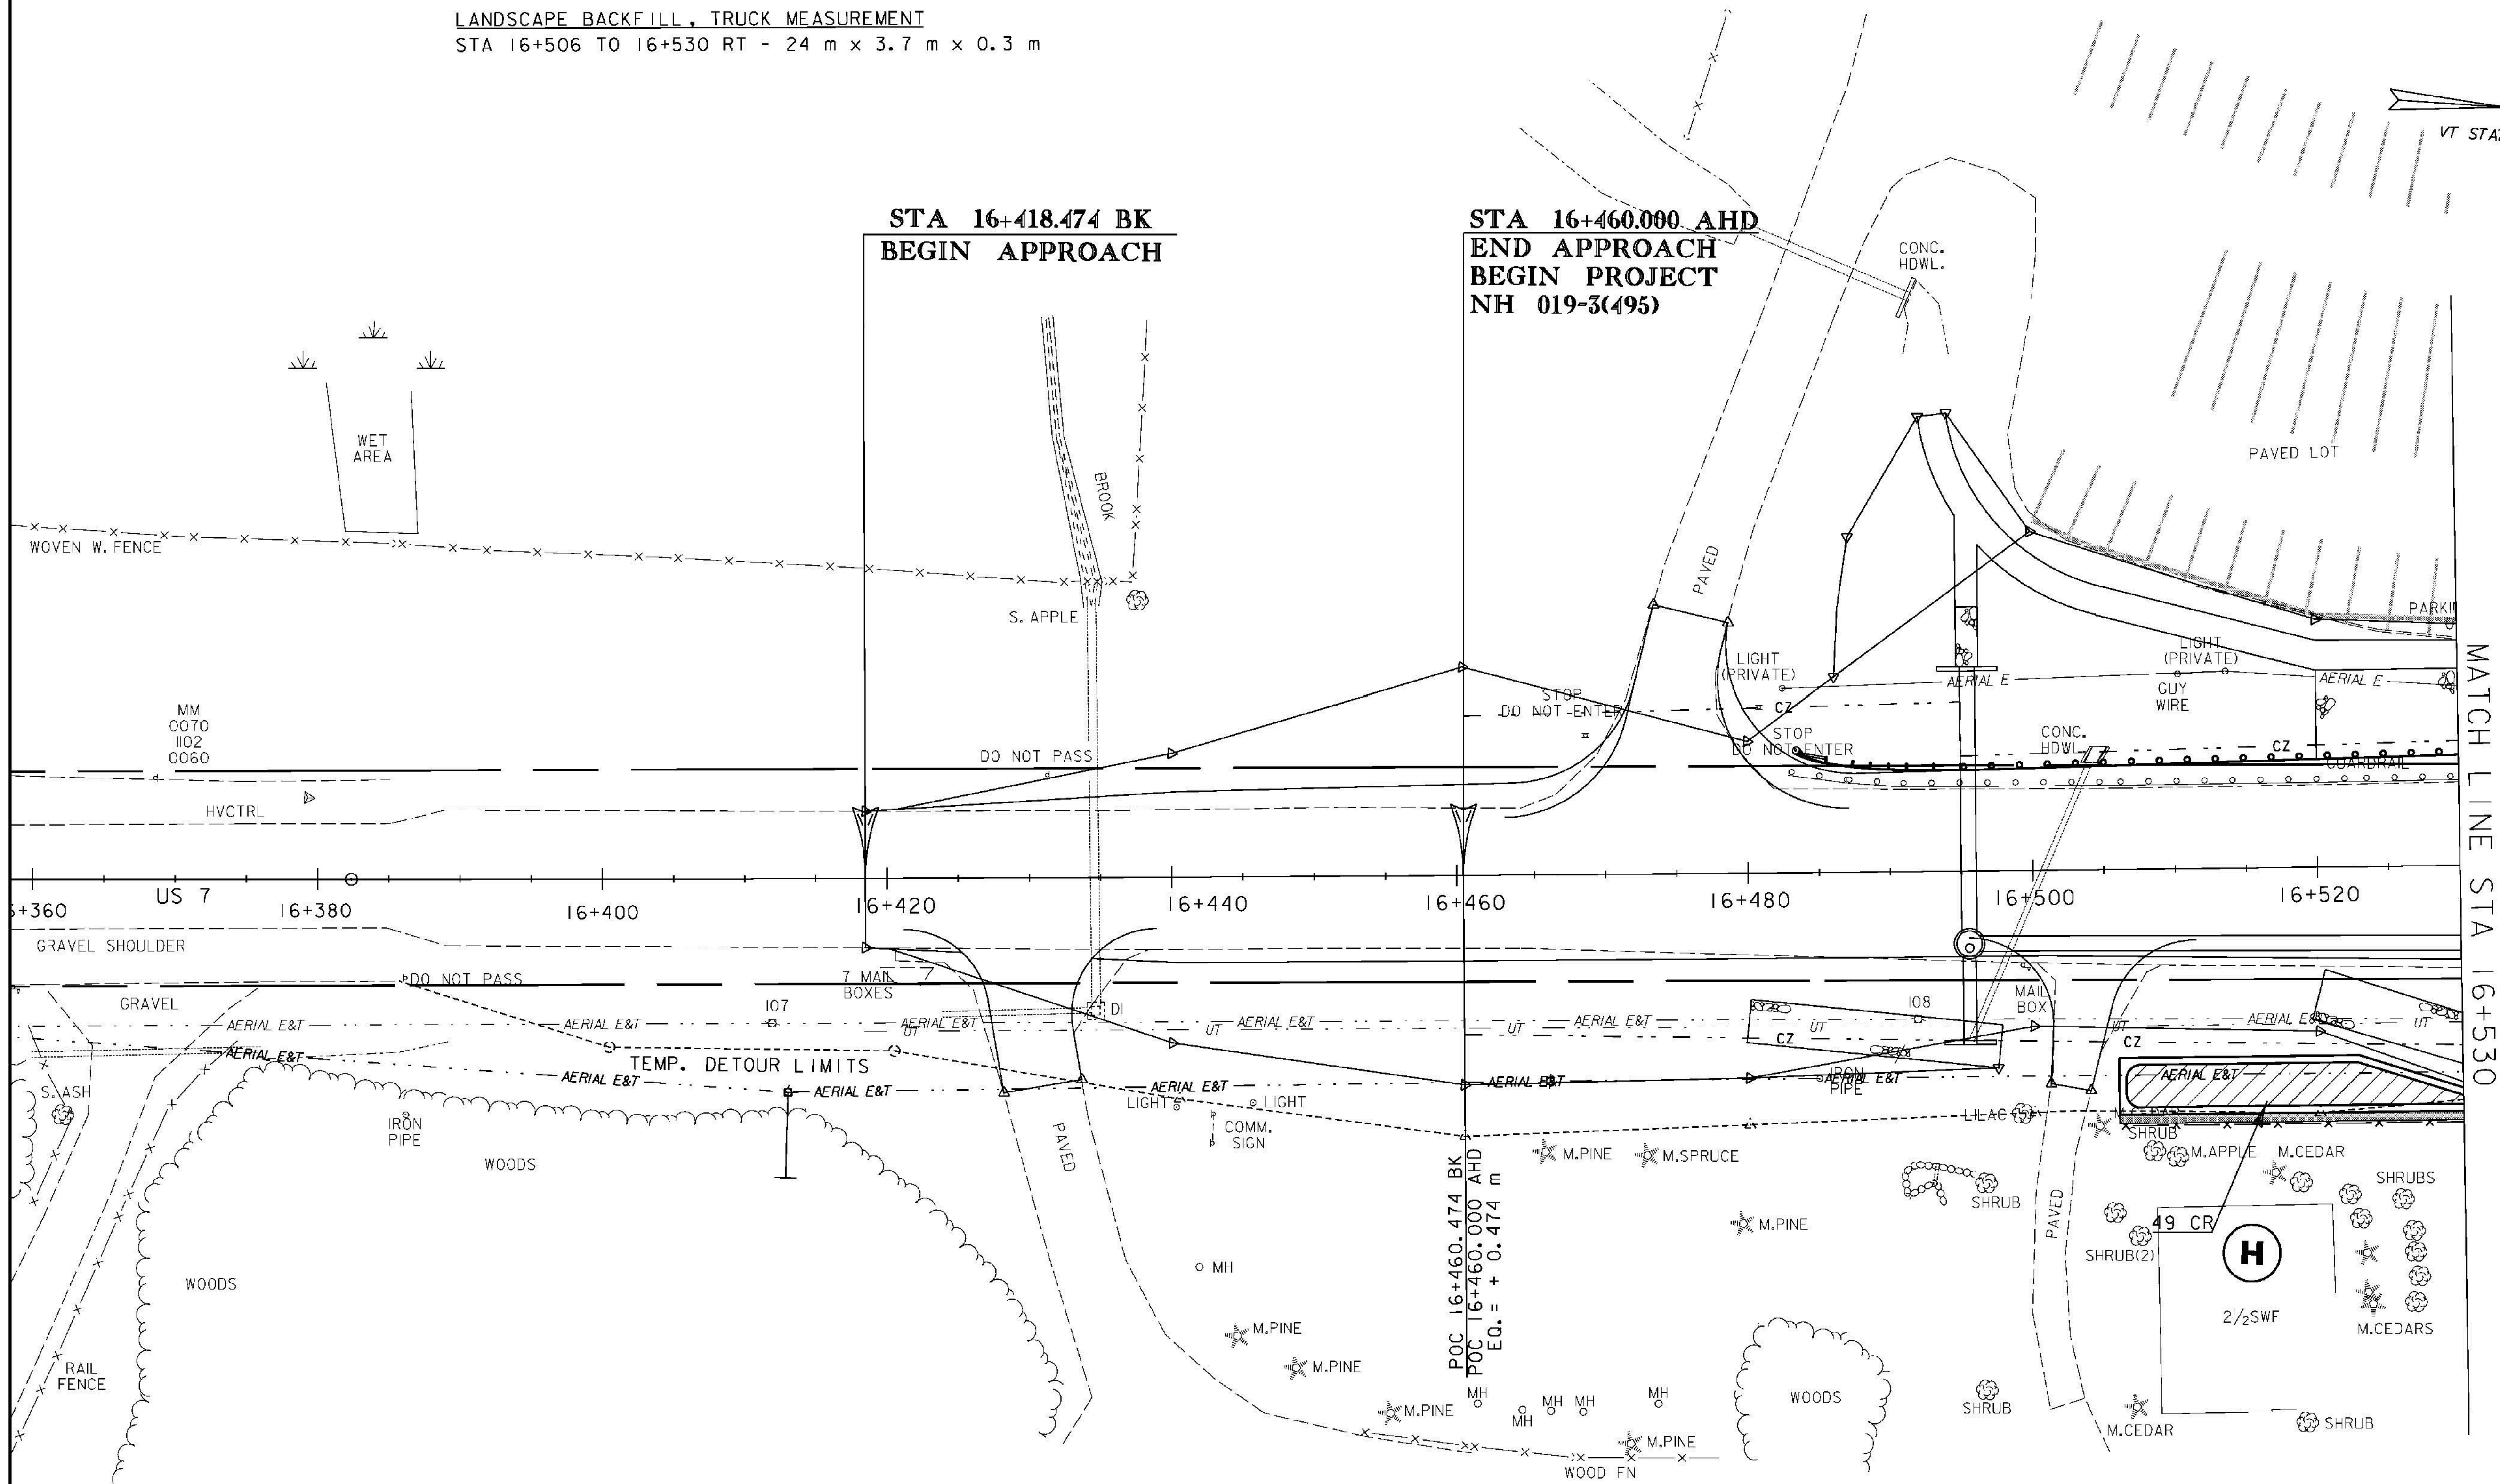

MATCH LINE STA 16+530

LEGEND

- LOWER HEIGHT WOODY SHRUBS
- PROPOSED DECIDUOUS TREE
- PROPOSED CONIFEROUS TREE
- SAVE TREE / TREE PROTECTION ZONE WITH FENCING (TPZ)
- LIMIT OF CUT & FILL / GRASS SEEDING OF DISTURBED AREAS
- LANDSCAPE BACKFILL
- DENOTES TREE OR STUMP REMOVAL

LANDSCAPE PLAN I

PROJECT NAME: BRANDON		PLOT DATE: 9/3/2009	
PROJECT NUMBER: NH 019-3(495)		DRAWN BY: JCS	
FILE NAME: zb008s5-ldsc01.dgn	DESIGNED BY: VTRANS	CHECKED BY: VTRANS	SHEET 213 OF 546

