


MATCH LINE STA 16+690

MATCH LINE STA 16+850

**LEGEND**

- LOWER HEIGHT WOODY SHRUBS
- PROPOSED DECIDUOUS TREE
- PROPOSED CONIFEROUS TREE
- SAVE TREE / TREE PROTECTION ZONE WITH FENCING (TPZ)
- LIMIT OF CUT & FILL / GRASS SEEDING OF DISTURBED AREAS
- LANDSCAPE BACKFILL
- DENOTES TREE OR STUMP REMOVAL

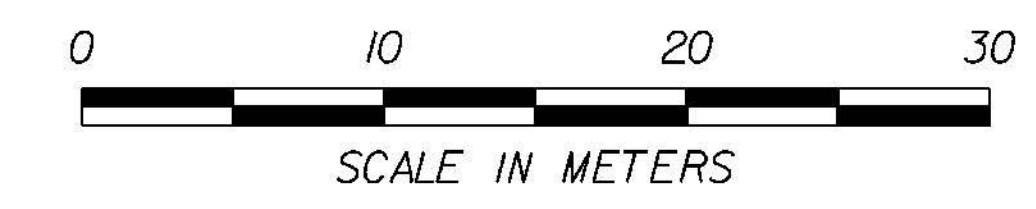

**LANDSCAPE PLAN 3**

PROJECT NAME: BRANDON		PLOT DATE: 9/3/2009	
PROJECT NUMBER: NH 019-3(495)		DRAWN BY: JCS	
FILE NAME: zb008s5-1dsc03.dgn	DESIGNED BY: VTRANS	CHECKED BY: VTRANS	SHEET 215 OF 546