


**DECIDUOUS TREES**  
 STA 17+110 TO 17+128 RT - 1 GT, 1 UC  
 STA 17+142 TO 17+160 RT - 1 GT, 1 UC

**TREE PROTECTION**  
 STA 17+130 TO 17+142 RT - 1 TREE

**LANDSCAPE BACKFILL, TRUCK MEASUREMENT**  
 STA 17+110 TO 17+128 RT - 18 m x 3 m x 1 m  
 STA 17+142 TO 17+160 RT - 18 m x 3 m x 1 m

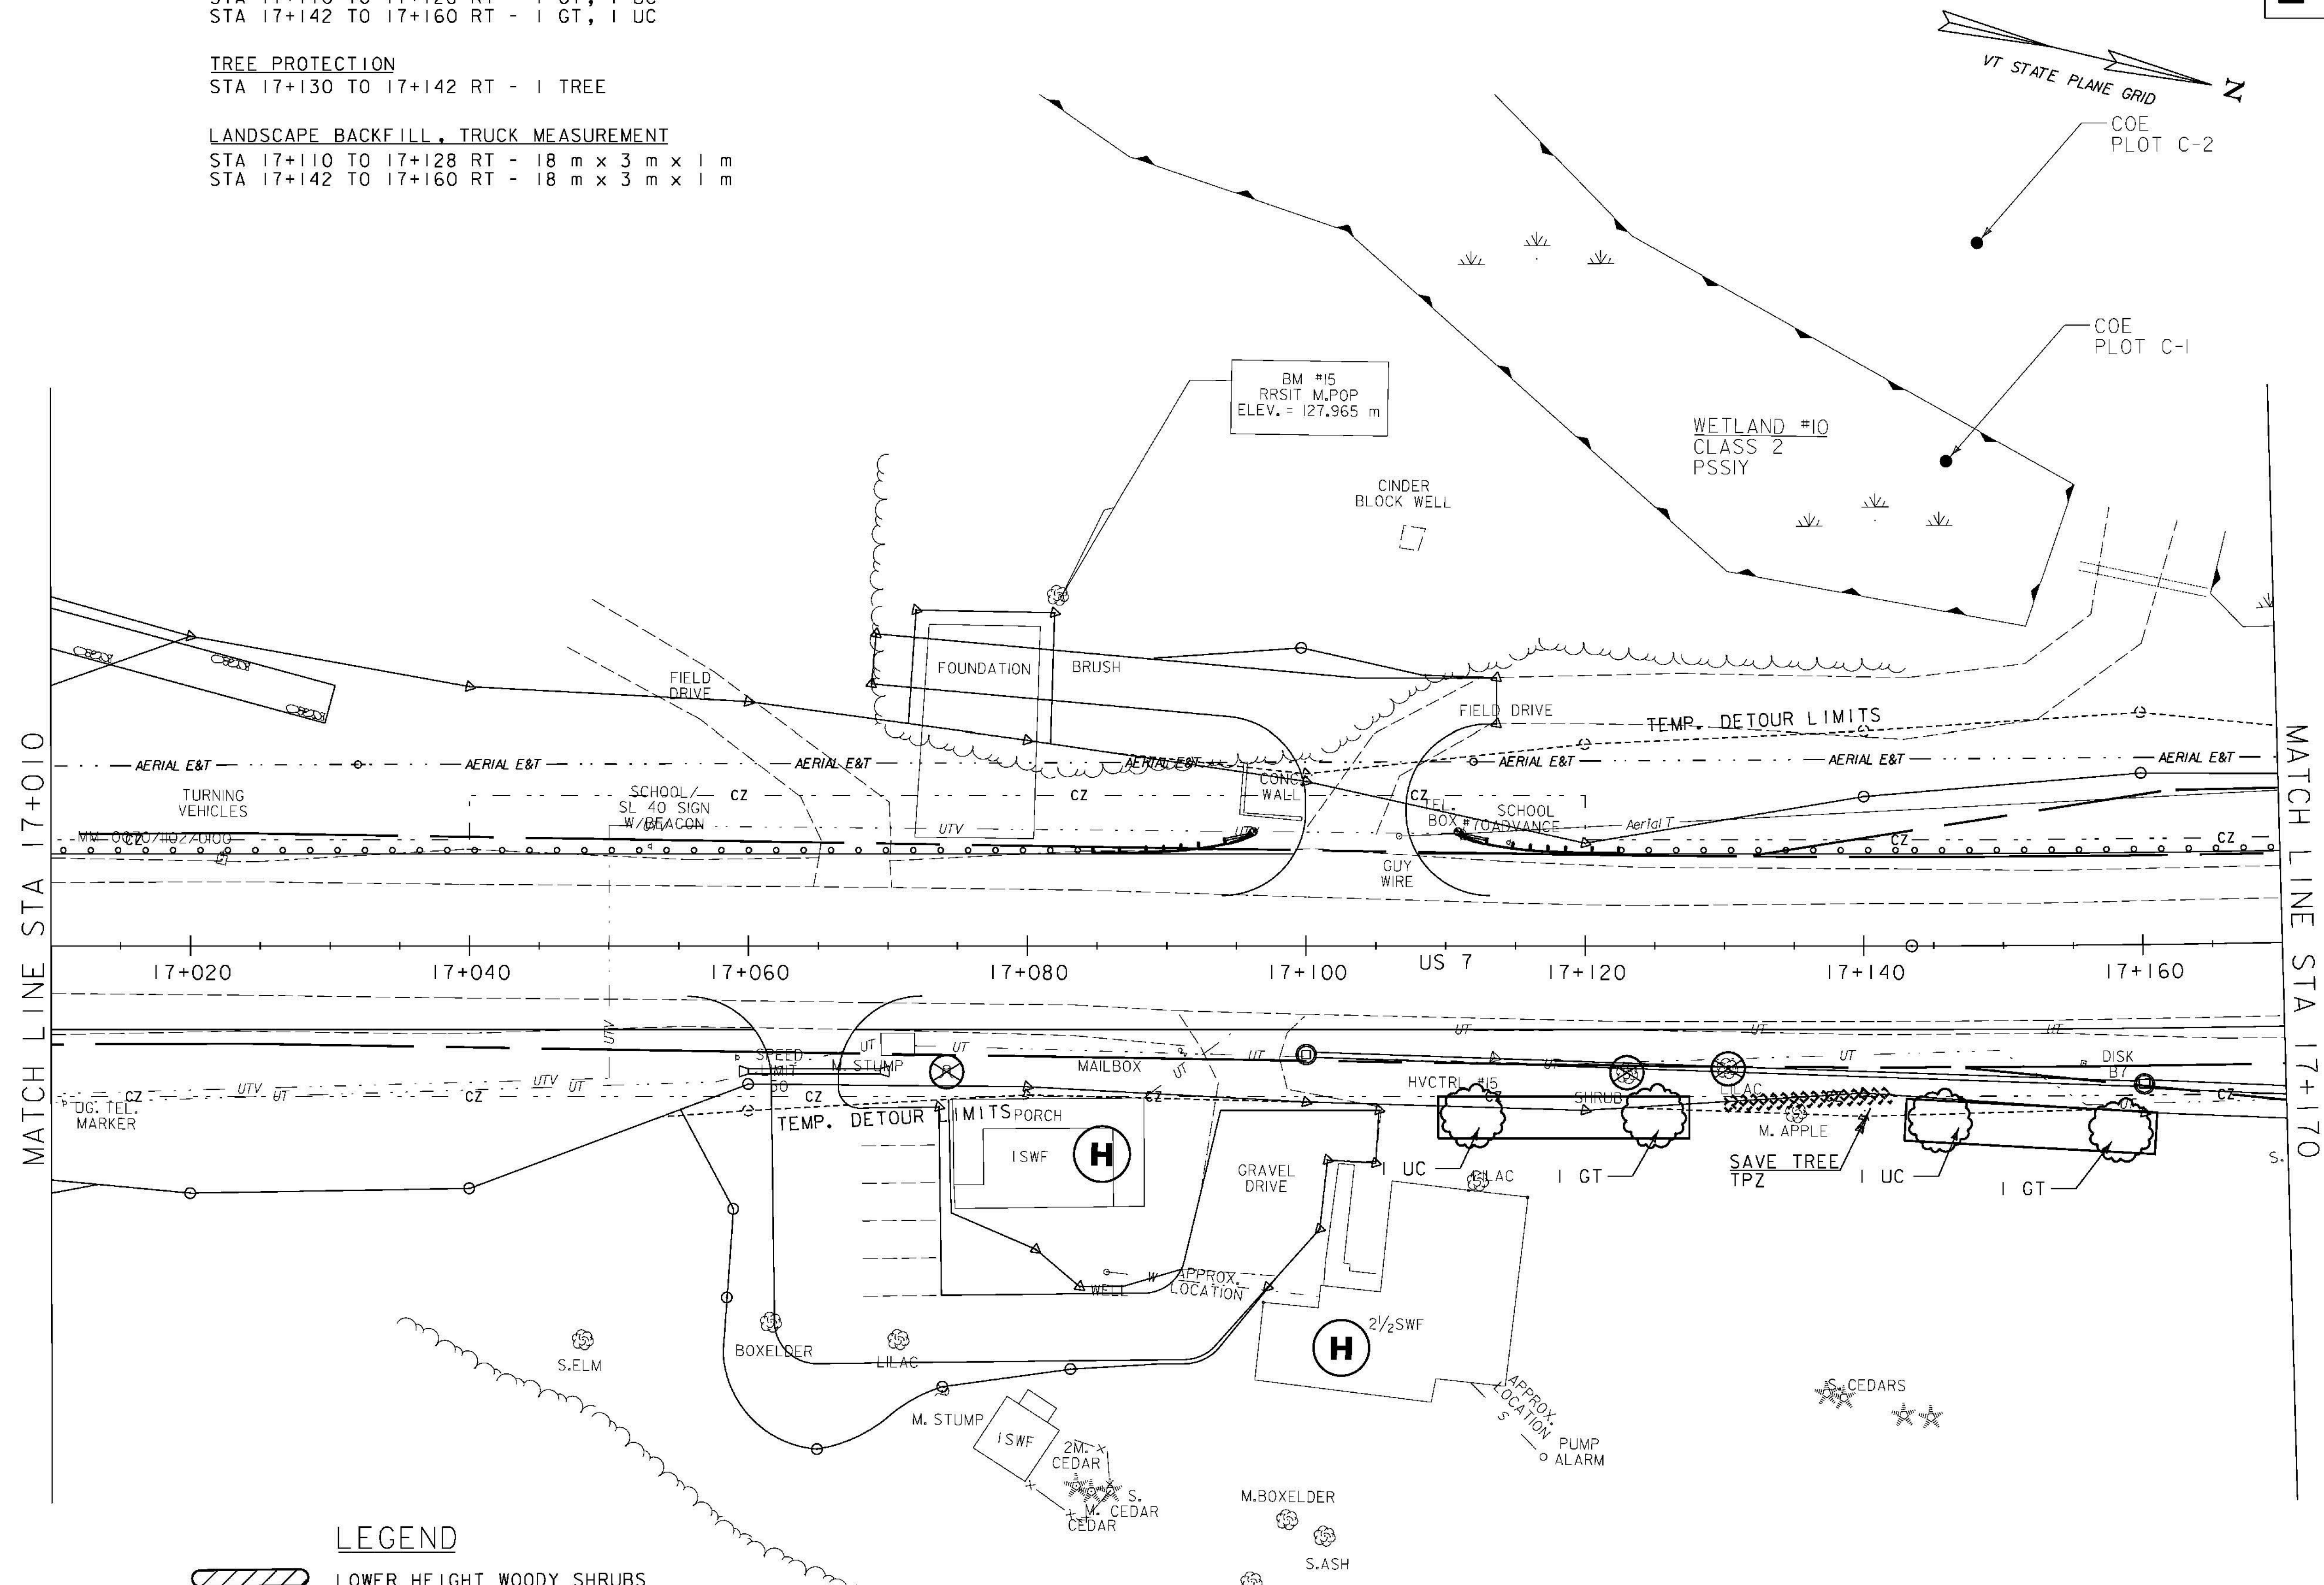

- LEGEND**
- LOWER HEIGHT WOODY SHRUBS
  - PROPOSED DECIDUOUS TREE
  - PROPOSED CONIFEROUS TREE
  - SAVE TREE / TREE PROTECTION ZONE WITH FENCING (TPZ)
  - LIMIT OF CUT & FILL / GRASS SEEDING OF DISTURBED AREAS
  - LANDSCAPE BACKFILL
  - DENOTES TREE OR STUMP REMOVAL



**LANDSCAPE PLAN 5**

PROJECT NAME:	BRANDON	PLOT DATE:	9/3/2009
PROJECT NUMBER:	NH 019-3(495)	DRAWN BY:	JCS
FILE NAME:	zb008s5-ldsc05.dgn	CHECKED BY:	VTRANS
PROJECT LEADER:	VTRANS	SHEET	217 OF 546
DESIGNED BY:	VTRANS		
CLD 02-0149			