


**DECIDUOUS TREES**  
 STA 17+330 LT - 1 GT  
 STA 17+374 LT - 1 QR  
 STA 17+381 LT - 1 GT  
 STA 17+388 LT - 1 QR

**LANDSCAPE BACKFILL, TRUCK MEASUREMENT**  
 STA 17+330 RT - 5 m x 3 m x 1 m  
 STA 17+374 - 17+388 LT - 17 m x 3 m x 1 m

**TREE PROTECTION**  
 STA 17+360 TO 17+372 LT - 1 TREE  
 STA 17+390 TO 17+405 LT - 1 TREE

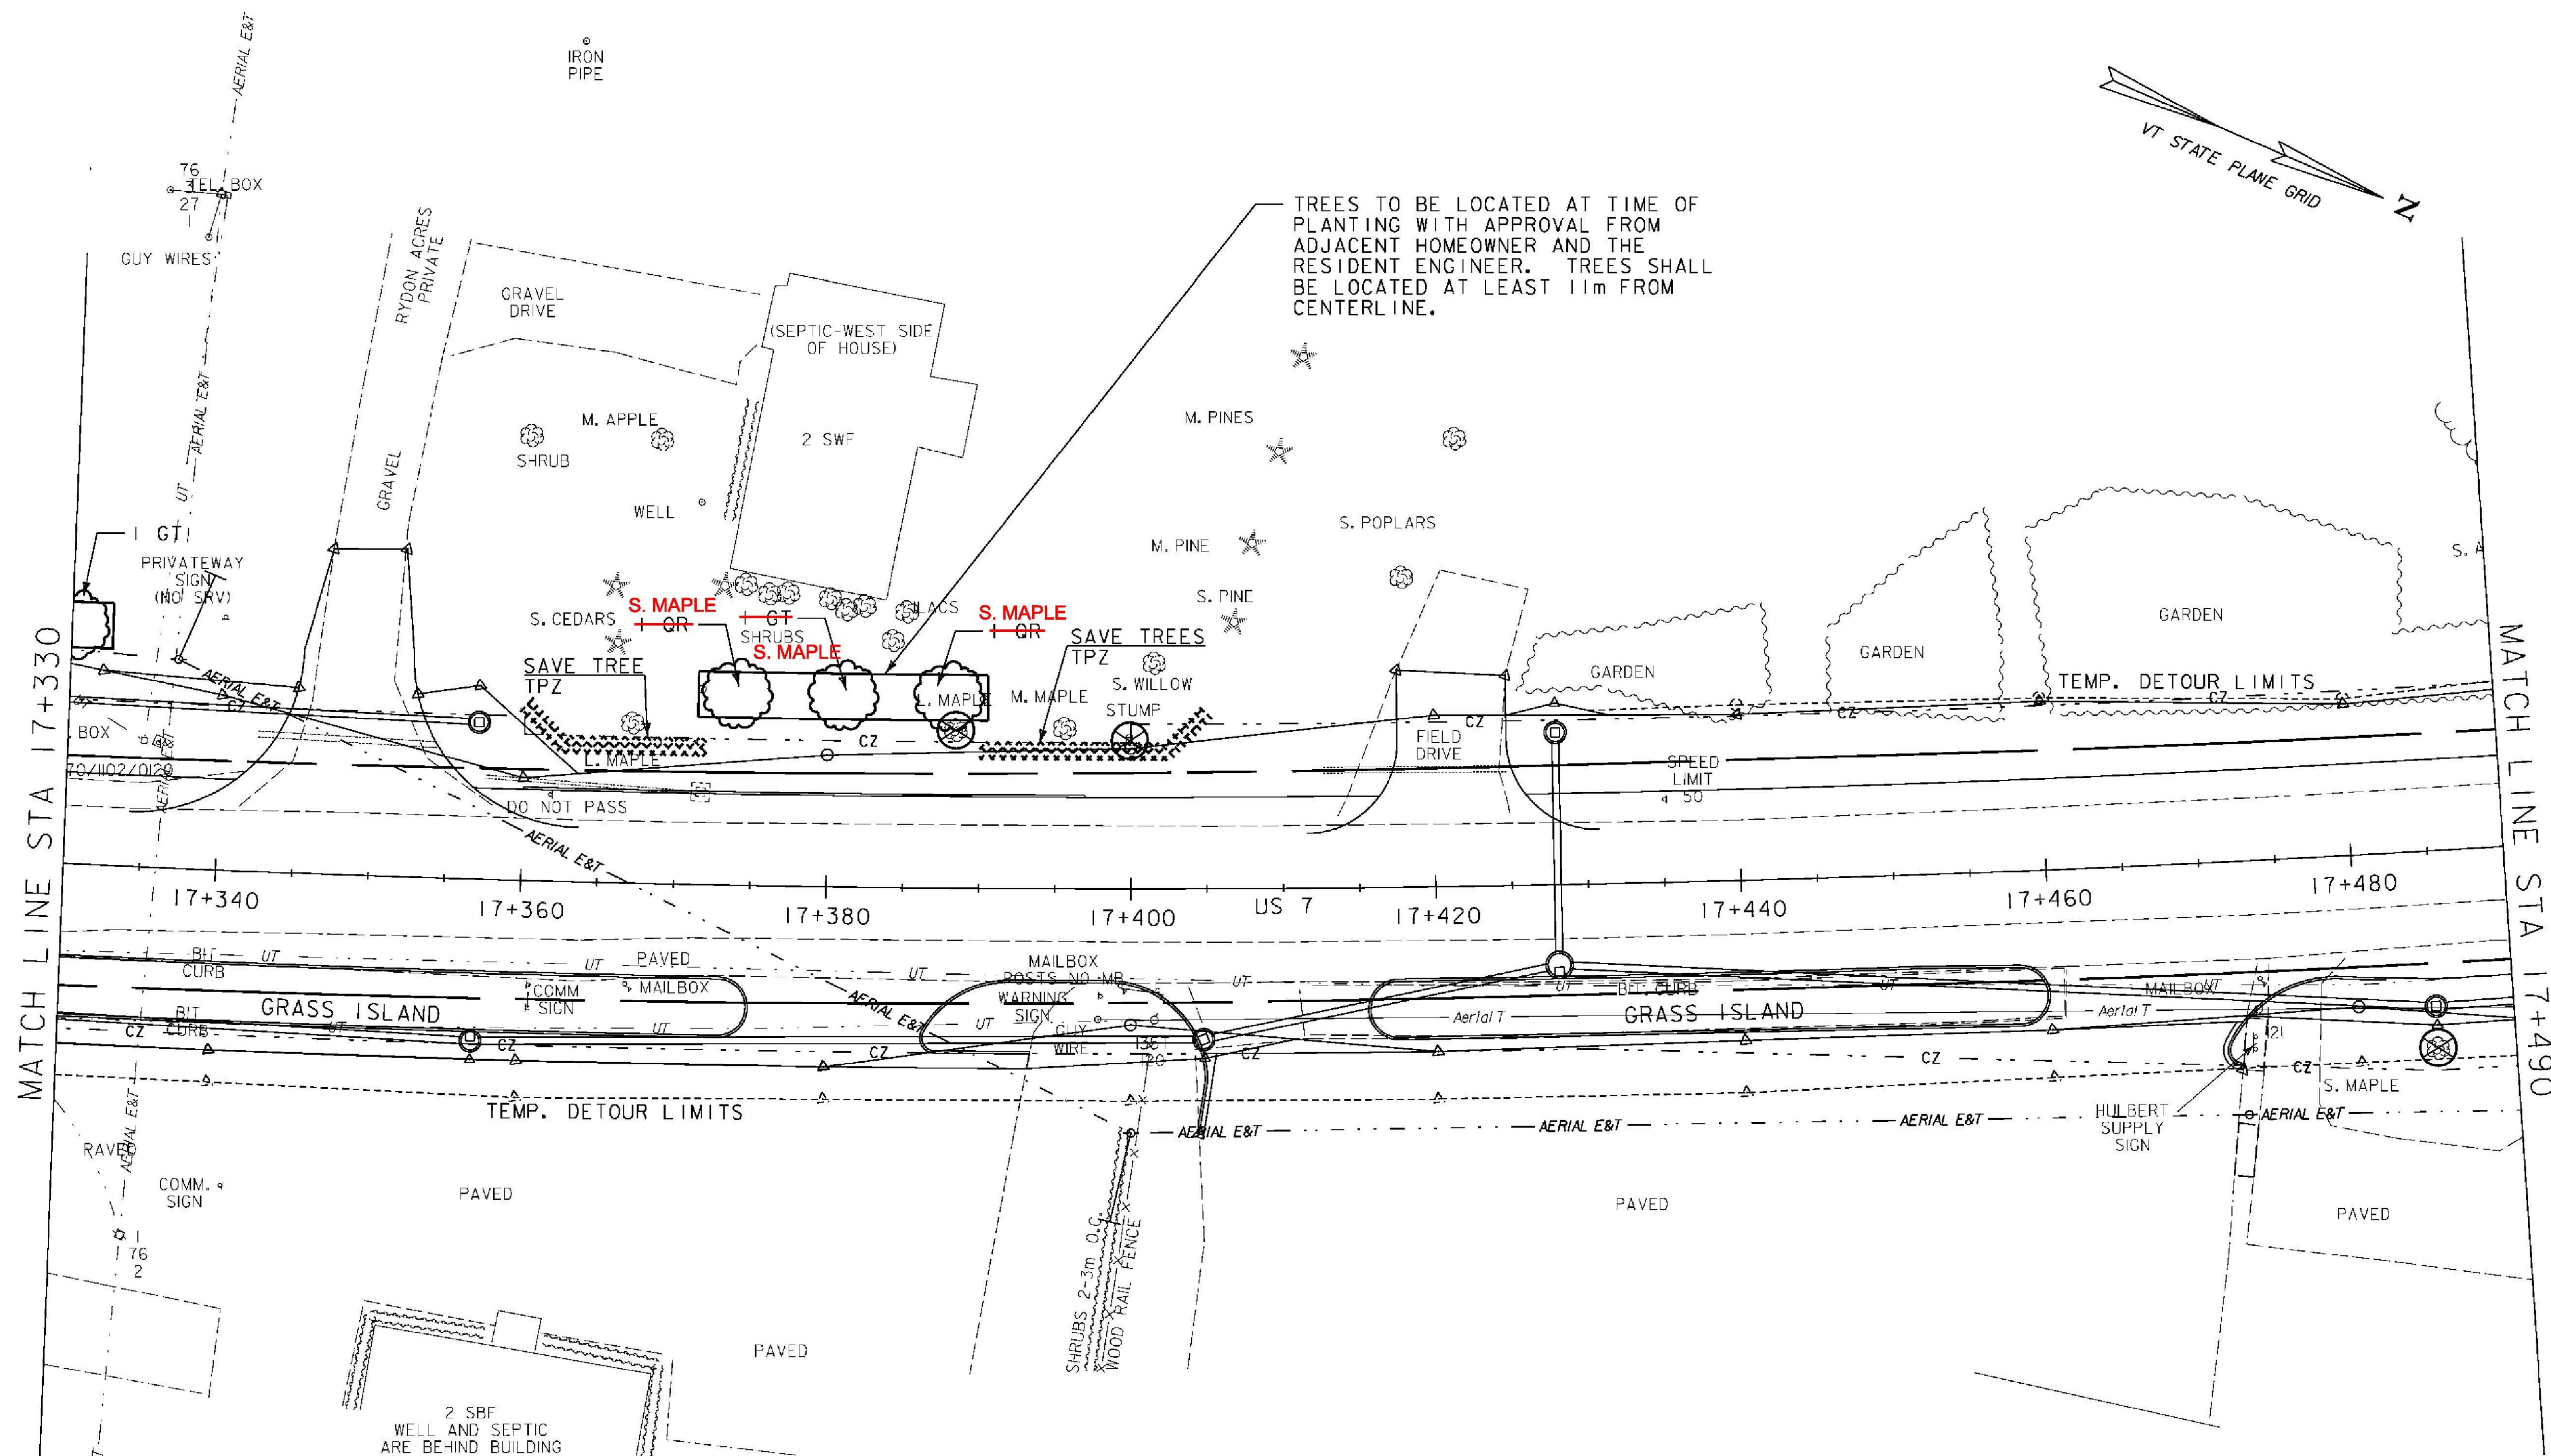

TREES TO BE LOCATED AT TIME OF PLANTING WITH APPROVAL FROM ADJACENT HOMEOWNER AND THE RESIDENT ENGINEER. TREES SHALL BE LOCATED AT LEAST 11m FROM CENTERLINE.

MATCH LINE STA 17+330

MATCH LINE STA 17+490

**LEGEND**

- LOWER HEIGHT WOODY SHRUBS
- PROPOSED DECIDUOUS TREE
- PROPOSED CONIFEROUS TREE
- SAVE TREE / TREE PROTECTION ZONE WITH FENCING (TPZ)
- LIMIT OF CUT & FILL / GRASS SEEDING OF DISTURBED AREAS
- LANDSCAPE BACKFILL
- DENOTES TREE OR STUMP REMOVAL

WELL IS NORTH OF BUILDING  
 SEPTIC IS BEHIND BUILDING



**LANDSCAPE PLAN 7**

PROJECT NAME: BRANDON	PLOT DATE: 9/3/2009
PROJECT NUMBER: NH 019-3(495)	DRAWN BY: JCS
FILE NAME: zb008s5-ldsc07.dgn	CHECKED BY: VTRANS
PROJECT LEADER: VTRANS	SHEET 219 OF 546
DESIGNED BY: VTRANS	
CLD 02-0149	