
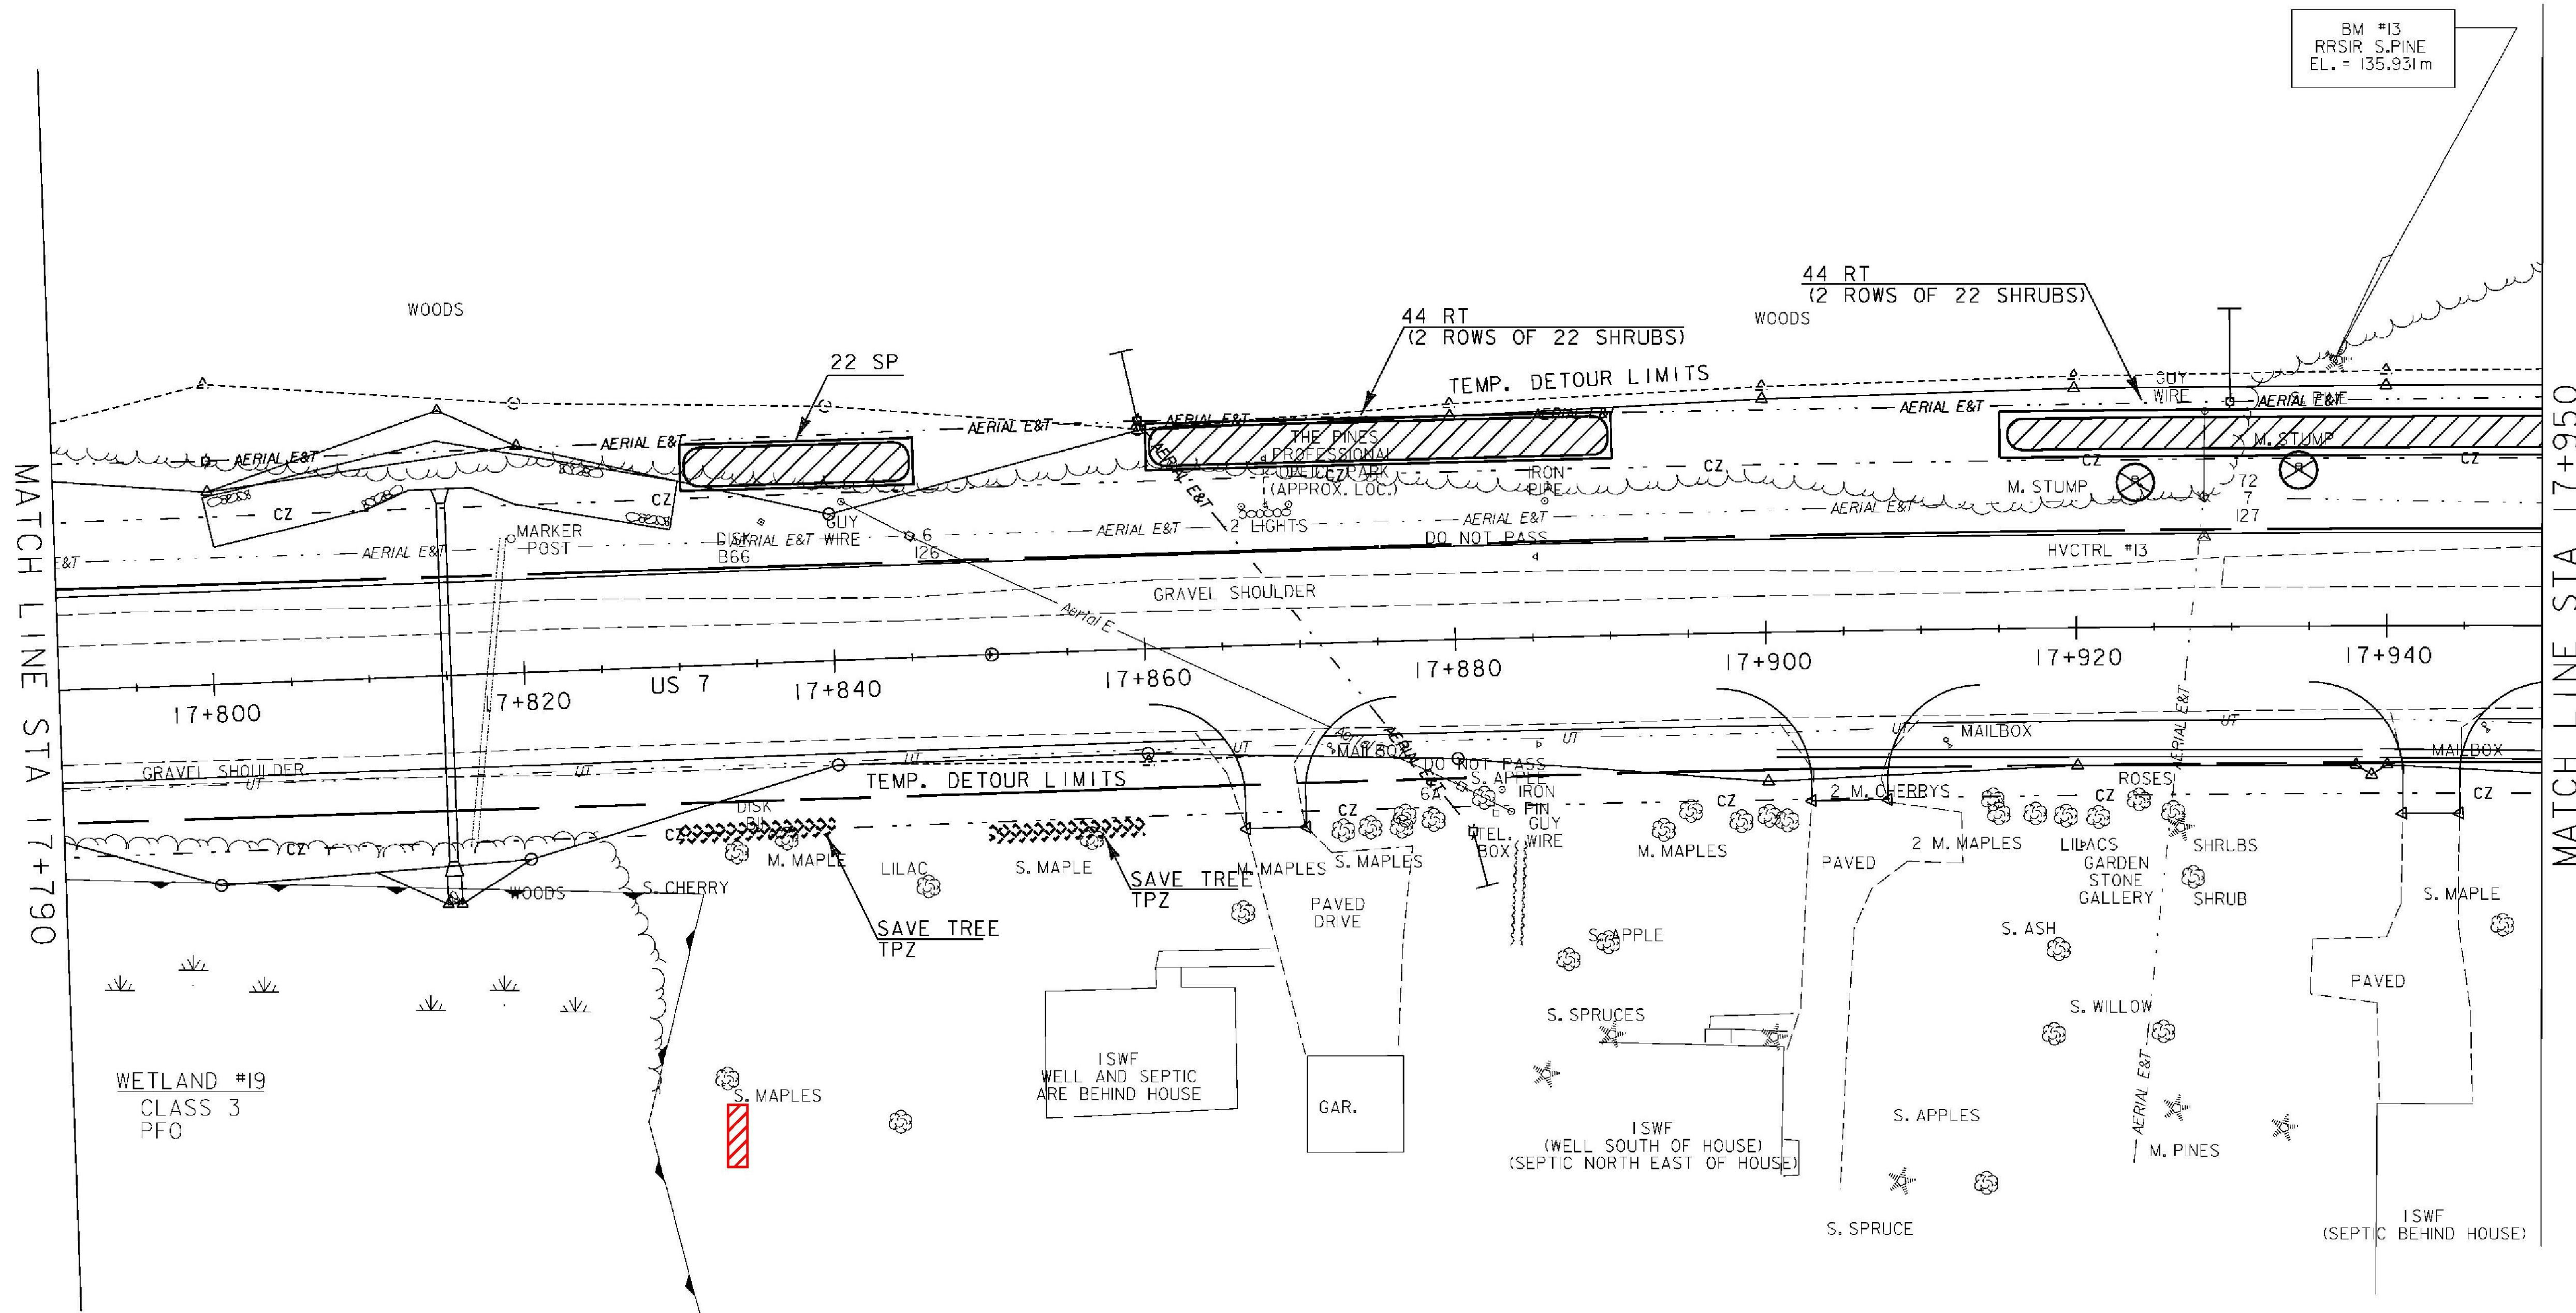


DECIDUOUS SHRUBS 24
 STA 17+830 TO 17+845 LT - 22 SP
 STA 17+860 TO 17+890 LT - 44 RT
 STA 17+915 TO 17+950 LT - 44 RT
STA 17+565 TO 17+575 RT
TREE PROTECTION
 STA 17+830 TO 17+840 RT - 1 TREE
 STA 17+850 TO 17+860 RT - 1 TREE
LANDSCAPE BACKFILL, TRUCK MEASUREMENT
 STA 17+830 TO 17+845 LT - 15 m x 3 m x 0.3 m
 STA 17+860 TO 17+890 LT - 30 m x 3 m x 0.3 m
 STA 17+915 TO 17+950 RT - 30 m x 3 m x 0.3 m

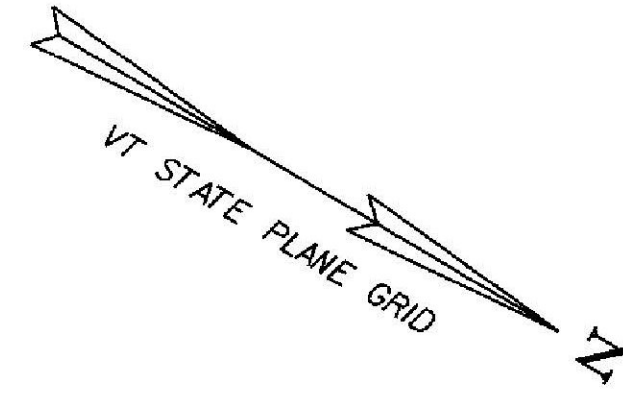

MATCH LINE STA 17+790

MATCH LINE STA 17+950

- LEGEND**
- LOWER HEIGHT WOODY SHRUBS
 - PROPOSED DECIDUOUS TREE
 - PROPOSED CONIFEROUS TREE
 - SAVE TREE / TREE PROTECTION ZONE WITH FENCING (TPZ)
 - LIMIT OF CUT & FILL / GRASS SEEDING OF DISTURBED AREAS
 - LANDSCAPE BACKFILL
 - DENOTES TREE OR STUMP REMOVAL



LANDSCAPE PLAN 10	
PROJECT NAME:	BRANDON
PROJECT NUMBER:	NH 019-3(495)
FILE NAME:	zb008s5-ldsc10.dgn
PROJECT LEADER:	VTRANS
DESIGNED BY:	VTRANS
CLD 02-0149	
PLOT DATE:	9/3/2009
DRAWN BY:	JCS
CHECKED BY:	VTRANS
SHEET	222 OF 546