
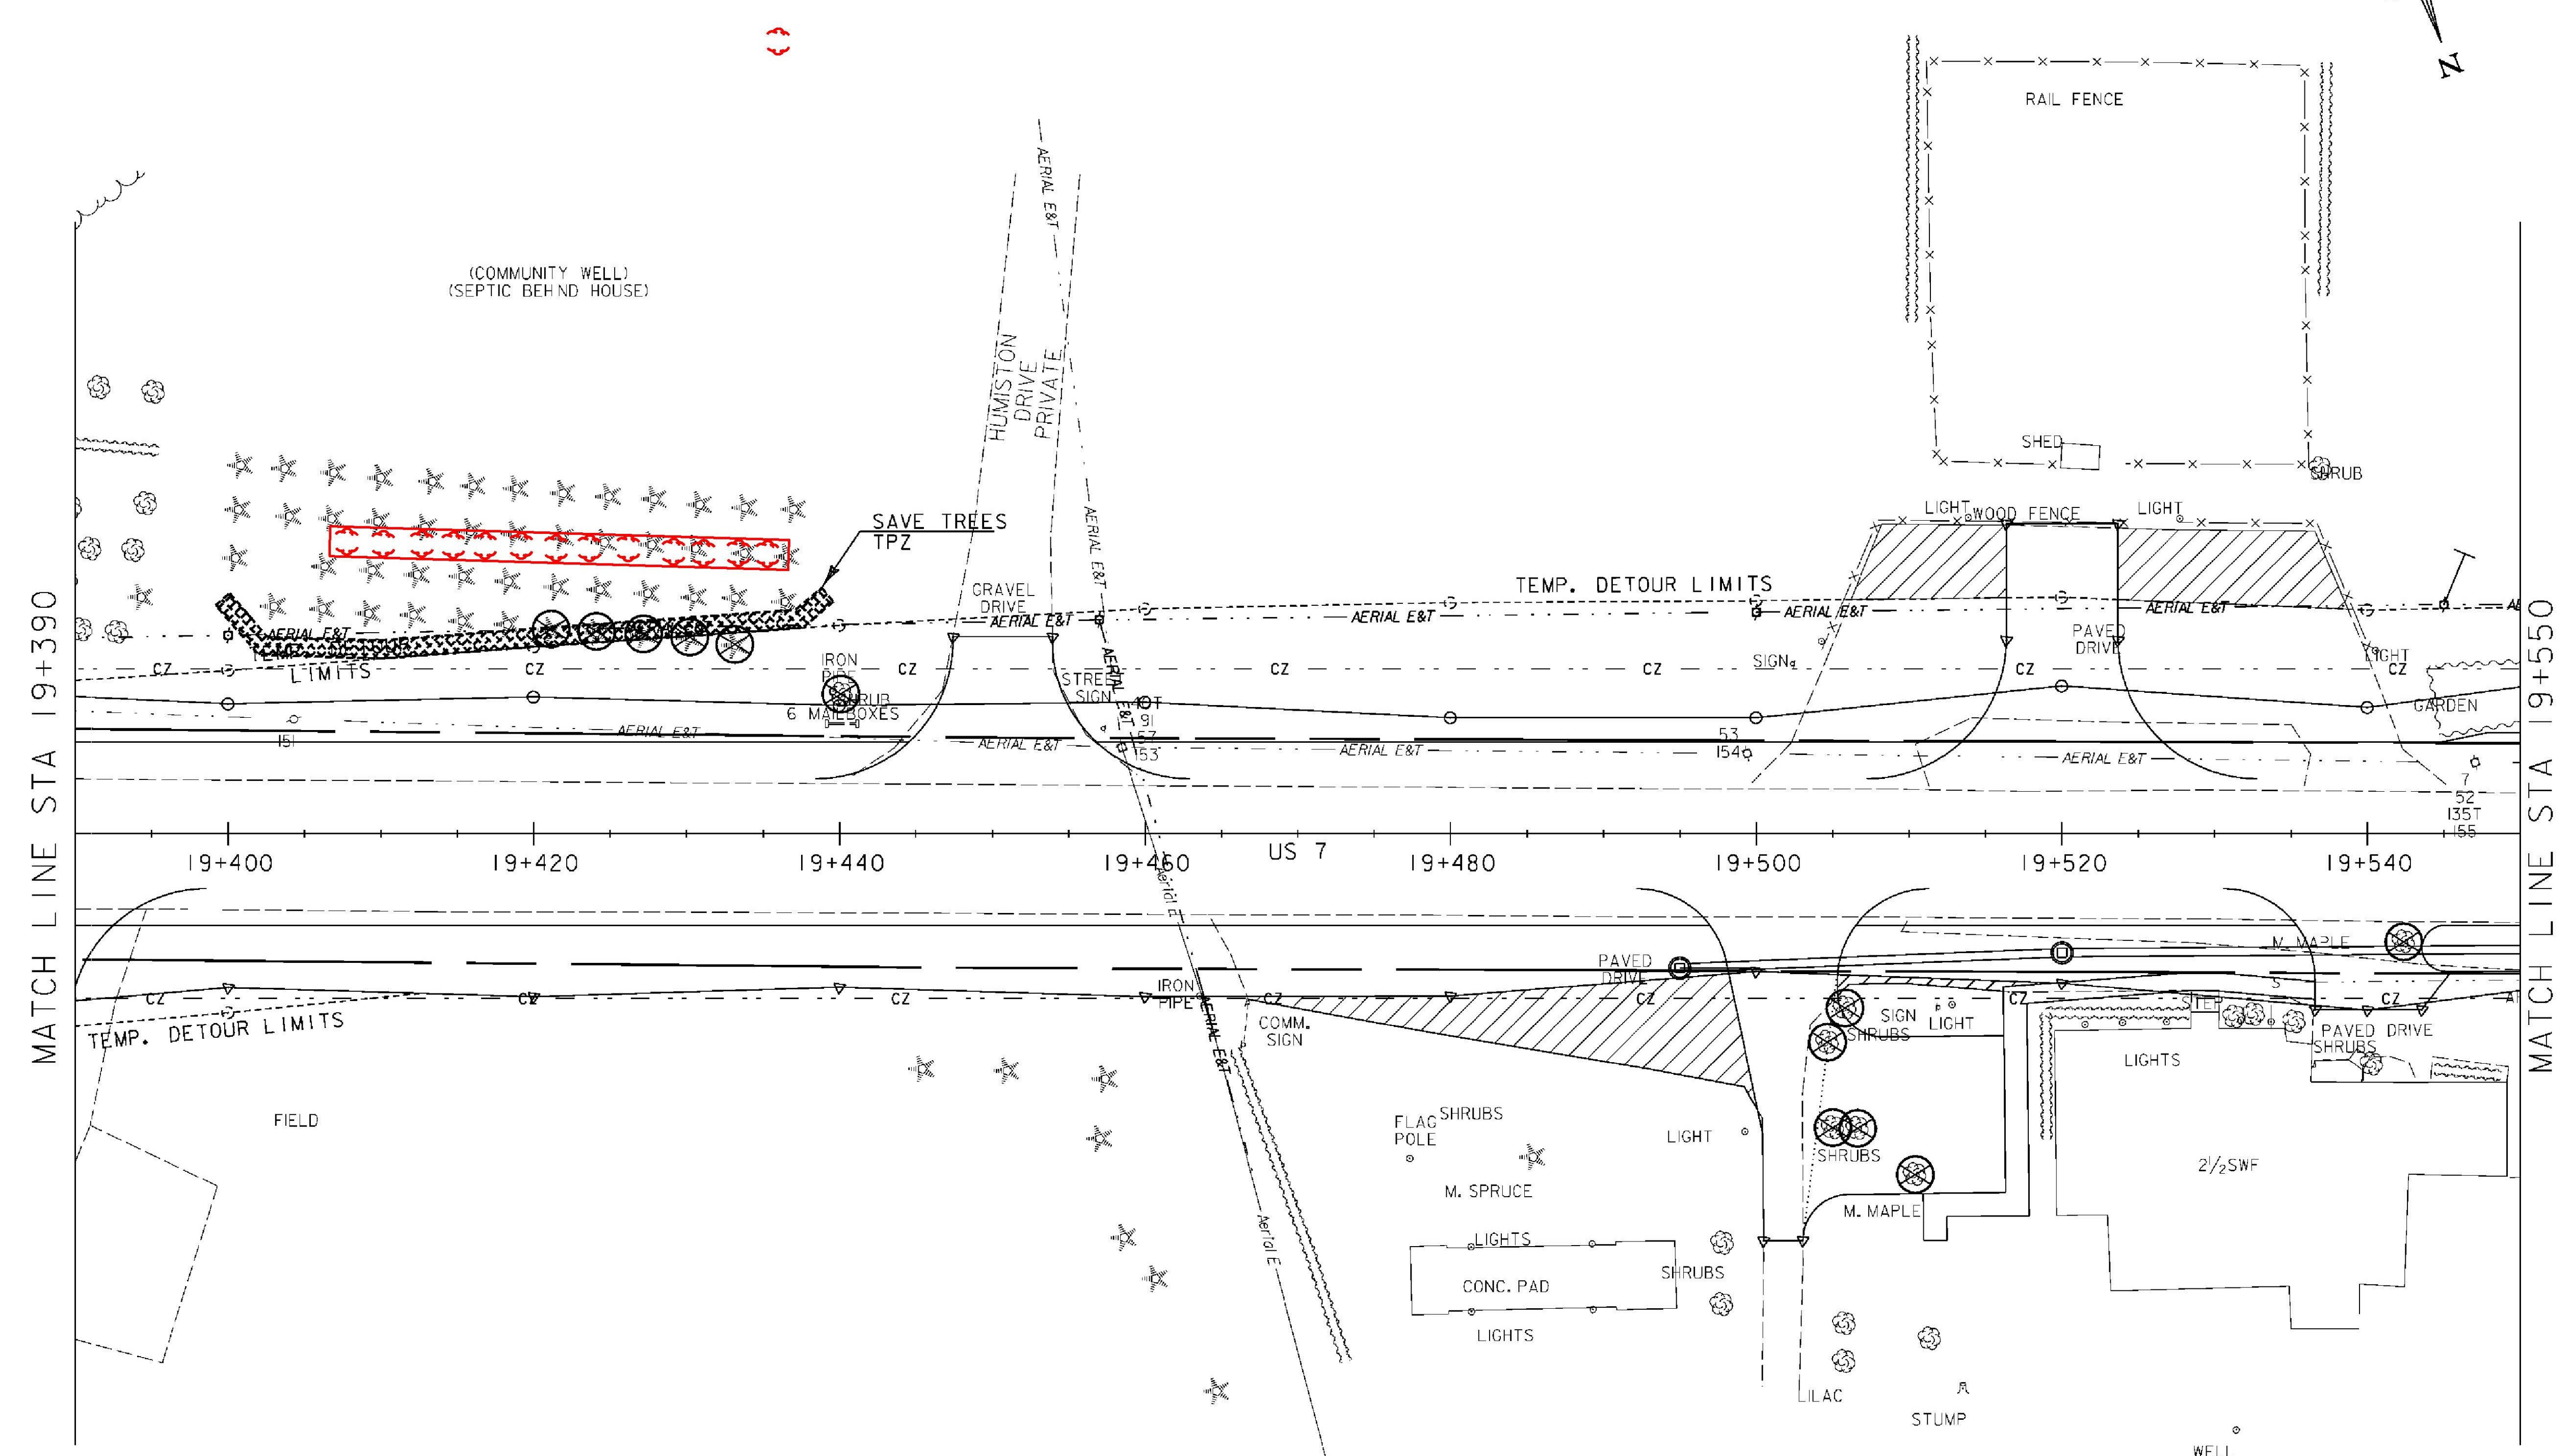


TREE PROTECTION
~~STA 19+399 TO 19+439 LT - 12 TREES~~

DECIDUOUS SHRUBS
 19+400 TO 19+420 LT - 13 - CRAB

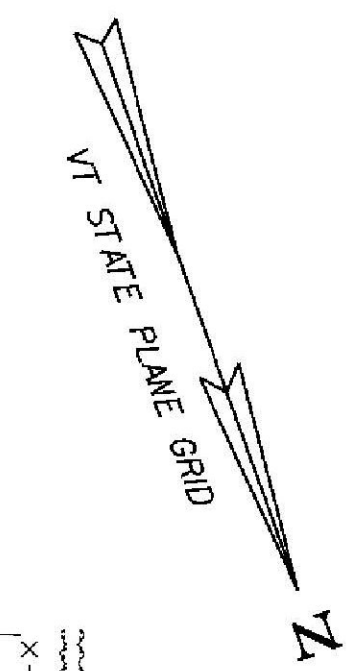

MATCH LINE STA 19+390

MATCH LINE STA 19+550

LEGEND

- LOWER HEIGHT WOODY SHRUBS
- PROPOSED DECIDUOUS TREE
- PROPOSED CONIFEROUS TREE
- SAVE TREE / TREE PROTECTION ZONE WITH FENCING (TPZ)
- LIMIT OF CUT & FILL / GRASS SEEDING OF DISTURBED AREAS
- LANDSCAPE BACKFILL
- DENOTES TREE OR STUMP REMOVAL



LANDSCAPE PLAN 20

PROJECT NAME: BRANDON	PLOT DATE: 9/3/2009
PROJECT NUMBER: NH 019-3(495)	DRAWN BY: JCS
FILE NAME: zb008s5-ldsc20.dgn	CHECKED BY: VTRANS
DESIGNED BY: VTRANS	SHEET 232 OF 546
CLD 02-0149	