


TEMPORARY 100mm WHITE LINE, PAINT
 DURABLE 100mm WHITE LINE, THERMOPLASTIC
 STA 16+850 TO 17+010 SOLID LT & RT

TEMPORARY 100mm YELLOW LINE, PAINT
 DURABLE 100mm YELLOW LINE, THERMOPLASTIC
 STA 16+850 TO 17+010 SOLID LT & RT

REMOVING SIGNS
 AS SHOWN - 2

SIGN LEGEND

R = REMOVE
 S = SALVAGE
 N = NEW
 RET = RETAIN
 T&T = THINNING & TRIMMING
 B-B = BACK TO BACK
 EXISTING -----
 NEW _____

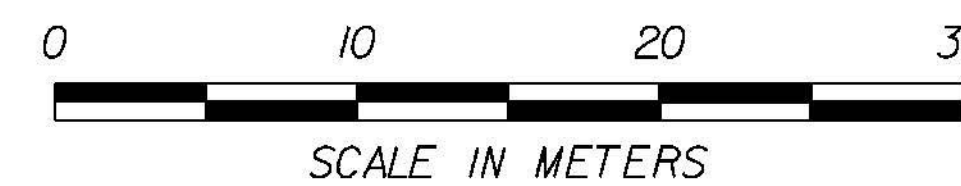

SIGNING & PAVEMENT MARKING 4

| | |
|-------------------------------|---------------------|
| PROJECT NAME: BRANDON | PLOT DATE: 9/3/2009 |
| PROJECT NUMBER: NH 019-3(495) | DRAWN BY: HJC |
| FILE NAME: zb008s5-+s04.dgn | CHECKED BY: PTS |
| PROJECT LEADER: CRB | SHEET 245 OF 546 |
| DESIGNED BY: NLL | |
| CLD 02-0149 | |