


TEMPORARY 100mm WHITE LINE, PAINT  
 DURABLE 100mm WHITE LINE, THERMOPLASTIC  
 STA 17+170 TO 17+330 SOLID LT & RT

TEMPORARY 100mm YELLOW LINE, PAINT  
 DURABLE 100mm YELLOW LINE, THERMOPLASTIC  
 STA 17+170 TO 17+330 SOLID LT & RT

REMOVING SIGNS  
 AS SHOWN - 2

**SIGN LEGEND**

R = REMOVE  
 S = SALVAGE  
 N = NEW  
 RET = RETAIN  
 T&T = THINNING & TRIMMING  
 B-B = BACK TO BACK  
 EXISTING  
 NEW

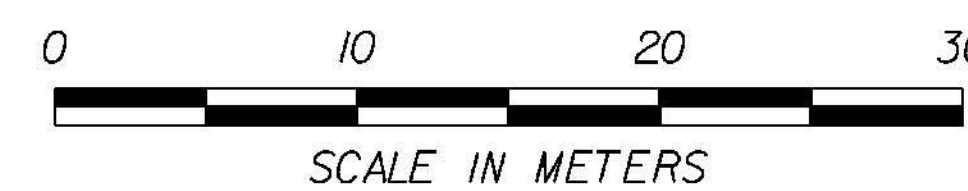

**SIGNING & PAVEMENT MARKING 6**

PROJECT NAME:	BRANDON	PLOT DATE:	9/3/2009
PROJECT NUMBER:	NH 019-3(495)	DRAWN BY:	HJC
FILE NAME:	zb008s5-+s06.dgn	CHECKED BY:	PTS
PROJECT LEADER:	CRB	SHEET	247 OF 546
DESIGNED BY:	NLL		
CLD 02-0149			