


- SIGN LEGEND**
- R = REMOVE
  - S = SALVAGE
  - N = NEW
  - RET = RETAIN
  - T&T = THINNING & TRIMMING
  - B-B = BACK TO BACK
  - EXISTING = EXISTING
  - NEW = NEW

- TEMPORARY 100mm WHITE LINE, PAINT  
DURABLE 100mm WHITE LINE, THERMOPLASTIC
- STA 17+490 TO 17+650 SOLID LT
  - STA 17+490 TO 17+541 SOLID RT
  - STA 17+490 TO 17+545 SOLID RT (LANE LINE)
  - STA 17+564 TO 17+650 SOLID RT
  - STA 1+008 TO 1+068 SOLID LT & RT (McCONNELL ROAD)
- TEMPORARY 100mm YELLOW LINE, PAINT  
DURABLE 100mm YELLOW LINE, THERMOPLASTIC
- STA 17+490 TO 17+550 SOLID LT & RT
  - STA 17+562 TO 17+650 SOLID LT & RT
  - STA 1+007 TO 1+068 SOLID LT & RT (McCONNELL ROAD)
  - STA 1+034 TO 1+048 SOLID LT & RT (McCONNELL ROAD)
- DURABLE 200mm YELLOW LINE, THERMOPLASTIC
- STA 1+034 TO 1+048 SOLID (DIAG LINES)

- TEMPORARY 600mm STOP BAR, PAINT  
DURABLE 600mm STOP BAR, THERMOPLASTIC
- STA 1+008 LT (McCONNELL ROAD) **LIMIT OF WORK**  
STA 1-068.000
- DURABLE LETTER OR SYMBOL, THERMOPLASTIC
- STA 17+505 RT - "ONLY"
  - STA 17+525 RT - RIGHT TURN ARROW
  - STA 1+011 LT - "STOP" (McCONNELL ROAD)
- TEMPORARY LETTER OR SYMBOL, PAINT
- STA 17+525 RT - RIGHT TURN ARROW
  - STA 1+011 LT - "STOP" (McCONNELL ROAD)
- PAINTED CURB
- STA 1+007 - 1+016 LT & RT (McCONNELL ROAD)

- REMOVING SIGNS  
AS SHOWN - 14
- ERECTING SALVAGED SIGNS  
AS SHOWN - 3
- SETTING SALVAGED POSTS  
AS SHOWN - 1

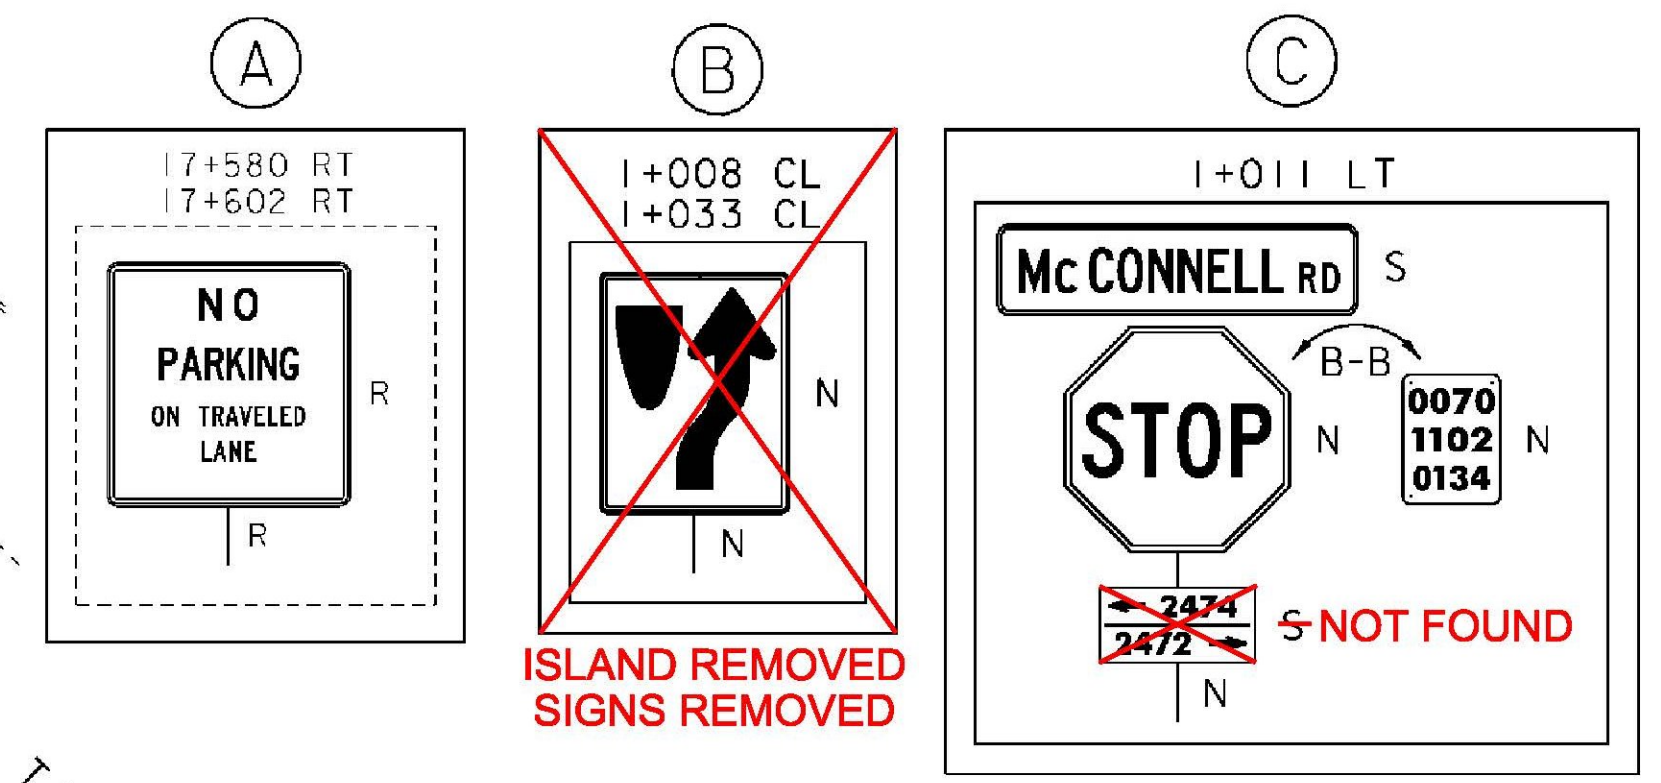

**SIGNING & PAVEMENT MARKING 8**

PROJECT NAME: BRANDON	PLOT DATE: 9/3/2009
PROJECT NUMBER: NH 019-3(495)	DRAWN BY: HJC
FILE NAME: zb008s5-ts08.dgn	DESIGNED BY: NLL
PROJECT LEADER: CRB	CHECKED BY: PTS
CLD 02-019	SHEET 249 OF 546