


TEMPORARY 100mm WHITE LINE, PAINT
 DURABLE 100mm WHITE LINE, THERMOPLASTIC
 STA 17+950 TO 18+110 SOLID LT & RT

TEMPORARY 100mm YELLOW LINE, PAINT
 DURABLE 100mm YELLOW LINE, THERMOPLASTIC
 STA 17+950 TO 18+080 SOLID LT, DASHED RT
 STA 18+080 TO 18+110 DASHED CL

REMOVING SIGNS
 AS SHOWN - 2

SIGN LEGEND

R = REMOVE
 S = SALVAGE
 N = NEW
 RET = RETAIN
 T&T = THINNING & TRIMMING
 B-B = BACK TO BACK
 EXISTING -----
 NEW _____

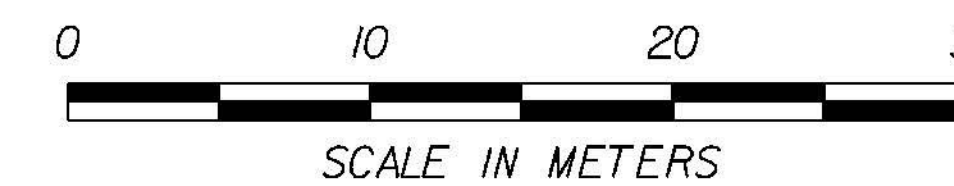

SIGNING & PAVEMENT MARKING II

PROJECT NAME: BRANDON	PLOT DATE: 9/3/2009
PROJECT NUMBER: NH 019-3(495)	DRAWN BY: HJC
FILE NAME: zb008s5-+sll.dgn	CHECKED BY: PTS
PROJECT LEADER: CRB	SHEET 252 OF 546
DESIGNED BY: NLL	
CLD 02-0149	