

TEMPORARY 100mm WHITE LINE, PAINT  
 DURABLE 100mm WHITE LINE, THERMOPLASTIC  
 STA 18+430 TO 18+590 SOLID LT & RT

TEMPORARY 100mm YELLOW LINE, PAINT  
 DURABLE 100mm YELLOW LINE, THERMOPLASTIC  
 STA 18+430 TO 18+590 SOLID LT, DASHED RT


**REMOVING SIGNS**  
 AS SHOWN - |

**ERECTING SALVAGED SIGNS**  
 AS SHOWN - |

**SETTING SALVAGED POSTS**  
 AS SHOWN - |

**SIGN LEGEND**

R = REMOVE  
 S = SALVAGE  
 N = NEW  
 RET = RETAIN  
 T&T = THINNING & TRIMMING  
 B-B = BACK TO BACK  
 EXISTING -----  
 NEW \_\_\_\_\_

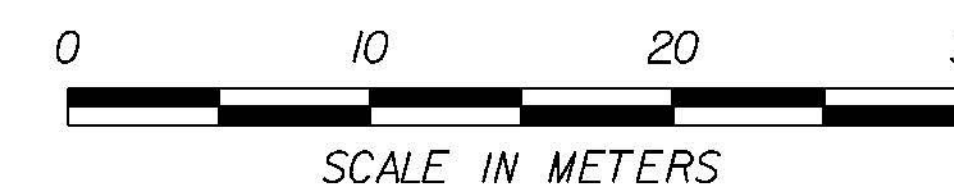

<b>SIGNING &amp; PAVEMENT MARKING 14</b>	
PROJECT NAME: BRANDON	PLOT DATE: 9/3/2009
PROJECT NUMBER: NH 019-3(495)	DRAWN BY: HJC
FILE NAME: zb008s5-+sl4.dgn	CHECKED BY: PTS
PROJECT LEADER: CRB	SHEET 255 OF 546
DESIGNED BY: NLL	
CLD 02-0149	