


TEMPORARY 100mm WHITE LINE, PAINT
 DURABLE 100mm WHITE LINE, THERMOPLASTIC
 STA 18+910 TO 19+070 SOLID LT
 STA 18+910 TO 19+003 SOLID RT
 STA 19+003 TO 19+012 SOLID RT (WOOD LANE)
 STA 19+018 TO 19+028 SOLID RT (WOOD LANE)
 STA 19+028 TO 19+070 SOLID RT

REMOVING SIGNS
 AS SHOWN - 13
 ERECTING SALVAGED SIGNS
 AS SHOWN - 4

TEMPORARY 100mm YELLOW LINE, PAINT
 DURABLE 100mm YELLOW LINE, THERMOPLASTIC
 STA 18+910 TO 19+009 SOLID LT & RT
 STA 19+015 SOLID RT (WOOD LANE)
 STA 19+021 TO 19+070 SOLID LT & RT


TEMPORARY 600mm STOP BAR, PAINT
 DURABLE 600mm STOP BAR, THERMOPLASTIC
 STA 19+015 TO 19+020 RT (WOOD LANE)

TEMPORARY LETTER OR SYMBOL, PAINT
 DURABLE LETTER OR SYMBOL, THERMOPLASTIC
 STA 19+016 RT - "STOP" (WOOD LANE)

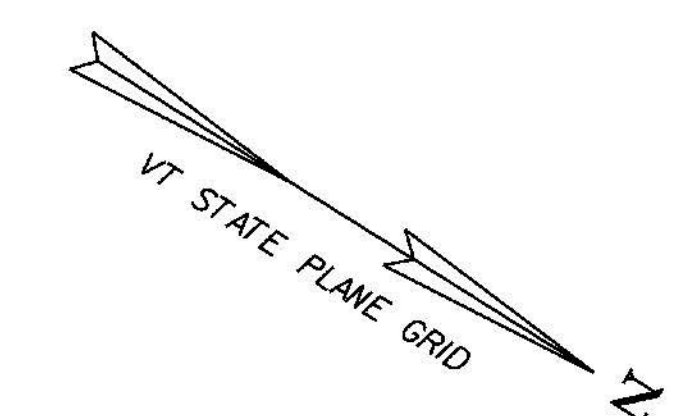

MATCH LINE STA 18+910

MATCH LINE STA 19+070

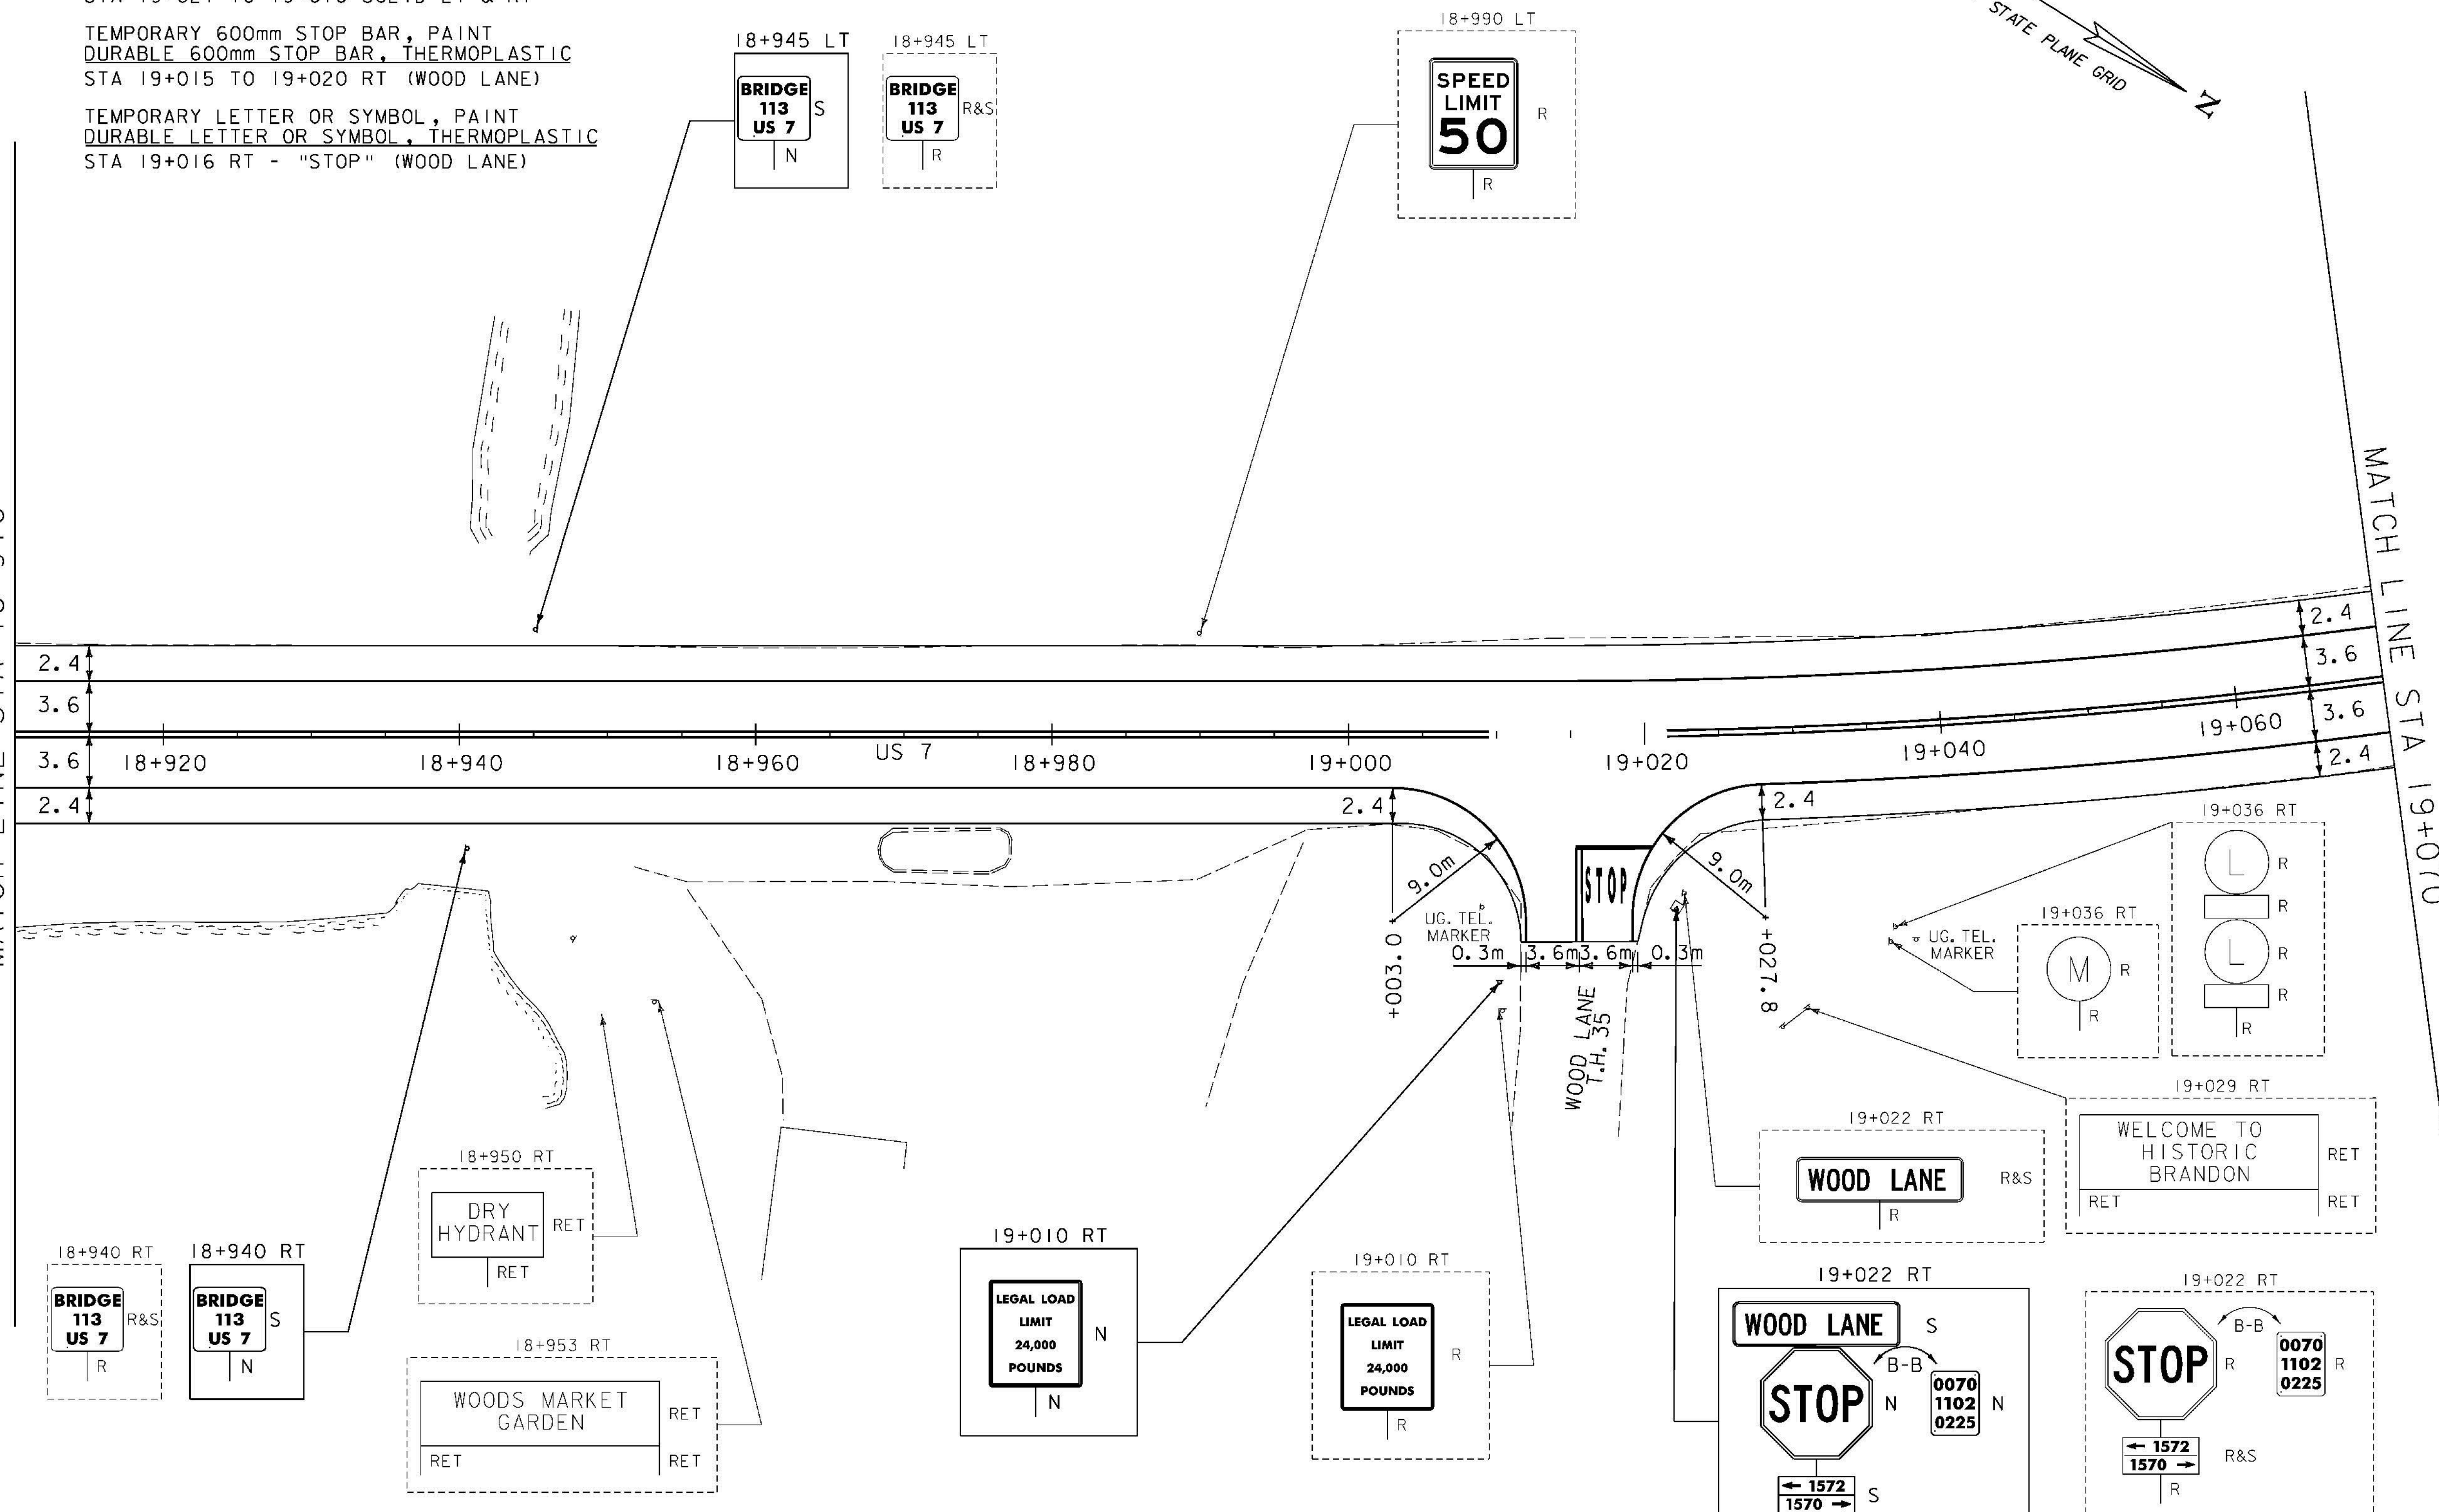

SIGN LEGEND

R = REMOVE
 S = SALVAGE
 N = NEW
 RET = RETAIN
 T&T = THINNING & TRIMMING
 B-B = BACK TO BACK
 EXISTING = Dashed line
 NEW = Solid line



SIGNING & PAVEMENT MARKING 17	
PROJECT NAME: BRANDON	PLOT DATE: 9/3/2009
PROJECT NUMBER: NH 019-3(495)	DRAWN BY: HJC
FILE NAME: zb008s5+sl7.dgn	CHECKED BY: PTS
PROJECT LEADER: CRB	SHEET 258 OF 546
DESIGNED BY: NLL	
CLD 02-0149	