


SALVAGE T.L.C.  
AS SHOWN - 1

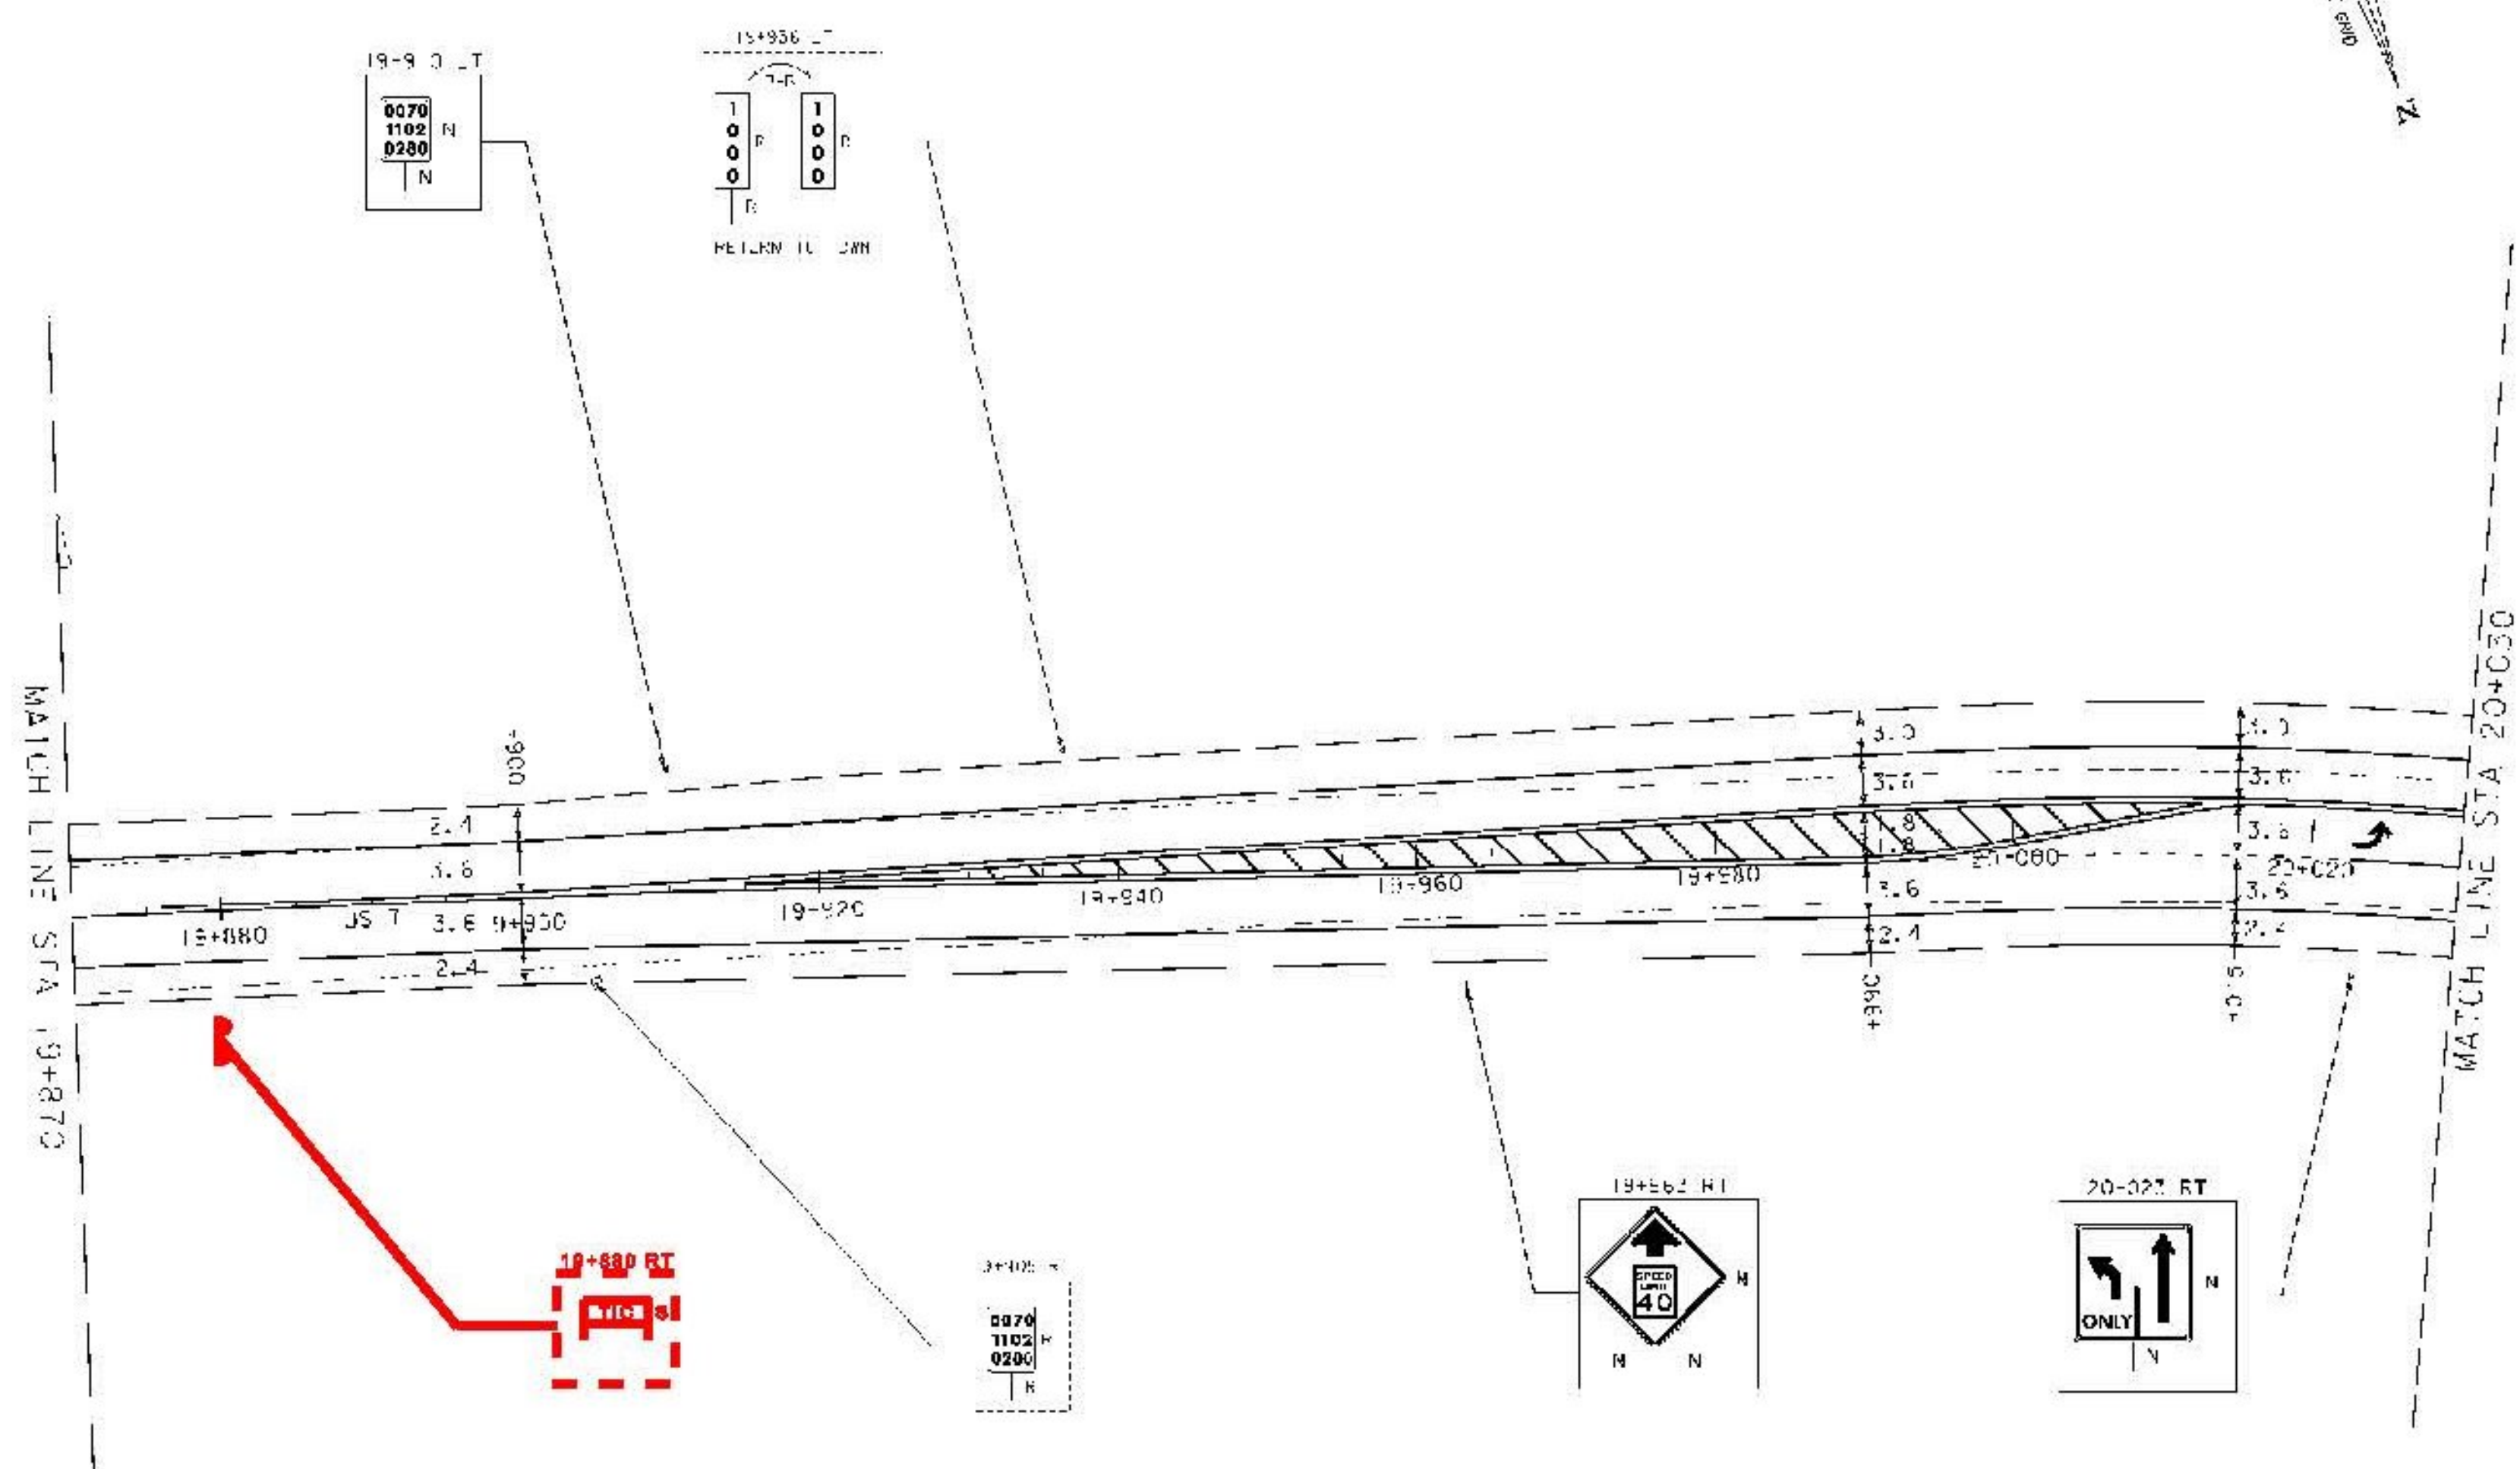

TEMPORARY 100mm WHITE LINE, PAINT  
DURABLE 100mm WHITE LINE, THERMOPLASTIC  
STA 9+870 TO 20+030 SOLID 1" & RT  
STA 9+990 TO 20+023 DOTTED RT LANE LINE  
STA 20+024 TO 20+020 SOLID 1" LANE LINE


TEMPORARY 100mm YELLOW LINE, PAINT  
DURABLE 100mm YELLOW LINE, THERMOPLASTIC  
STA 9+870 TO 19+880 DASHED LT SOLID RT  
STA 9+880 TO 19+930 SOLID 1" & RT  
STA 9+900 TO 20+015 SOLID 1" PAINTED SOLID  
STA 9+990 TO 20+015 SOLID 1" PAINTED SOLID  
STA 20+016 TO 20+030 SOLID 1" CENTERLINE

DURABLE 200mm YELLOW LINE, THERMOPLASTIC  
STA 19+300 TO 20+015 SOLID 1" & RT AS SHOWN

DURABLE WHITE OR YELLOW THERMOPLASTIC  
STA 20+323 CL - LEFT TURN ARROW

TEMPORARY WHITE OR YELLOW PAINT  
STA 20+323 CL - LEFT TURN ARROW

REMOVE NO SIGNS  
AS SHOWN

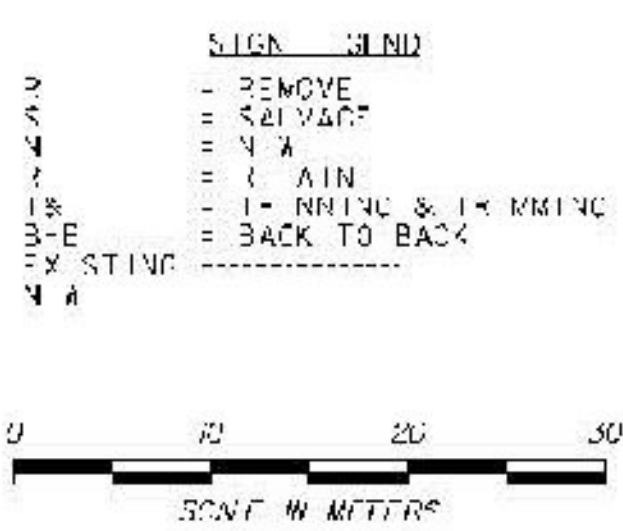

**SIGNING & PAVEMENT MARKING 23**

PROJECT NAME: BRANCON  
PROJECT NUMBER: NI 09 3495

FILE NAME: 200305-1323.dwg  
PROJECT LEADER: CFJ  
DATE: 05-11-09

PLOT DATE: 03/2009  
DRAWN BY: JCS  
CHECKED BY: JTS  
SHEET NO: OF 540