


TEMPORARY 100mm WHITE LINE, PAINT  
 DURABLE 100mm WHITE LINE, THERMOPLASTIC  
 STA 20+190 TO 20+350 SOLID LT & RT

TEMPORARY 100mm YELLOW LINE, PAINT  
 DURABLE 100mm YELLOW LINE, THERMOPLASTIC  
 STA 20+190 TO 20+350 SOLID LT & RT

REMOVING SIGNS  
 AS SHOWN - 2

**SALVAGET T.I.C.**  
 AS SHOWN - 2

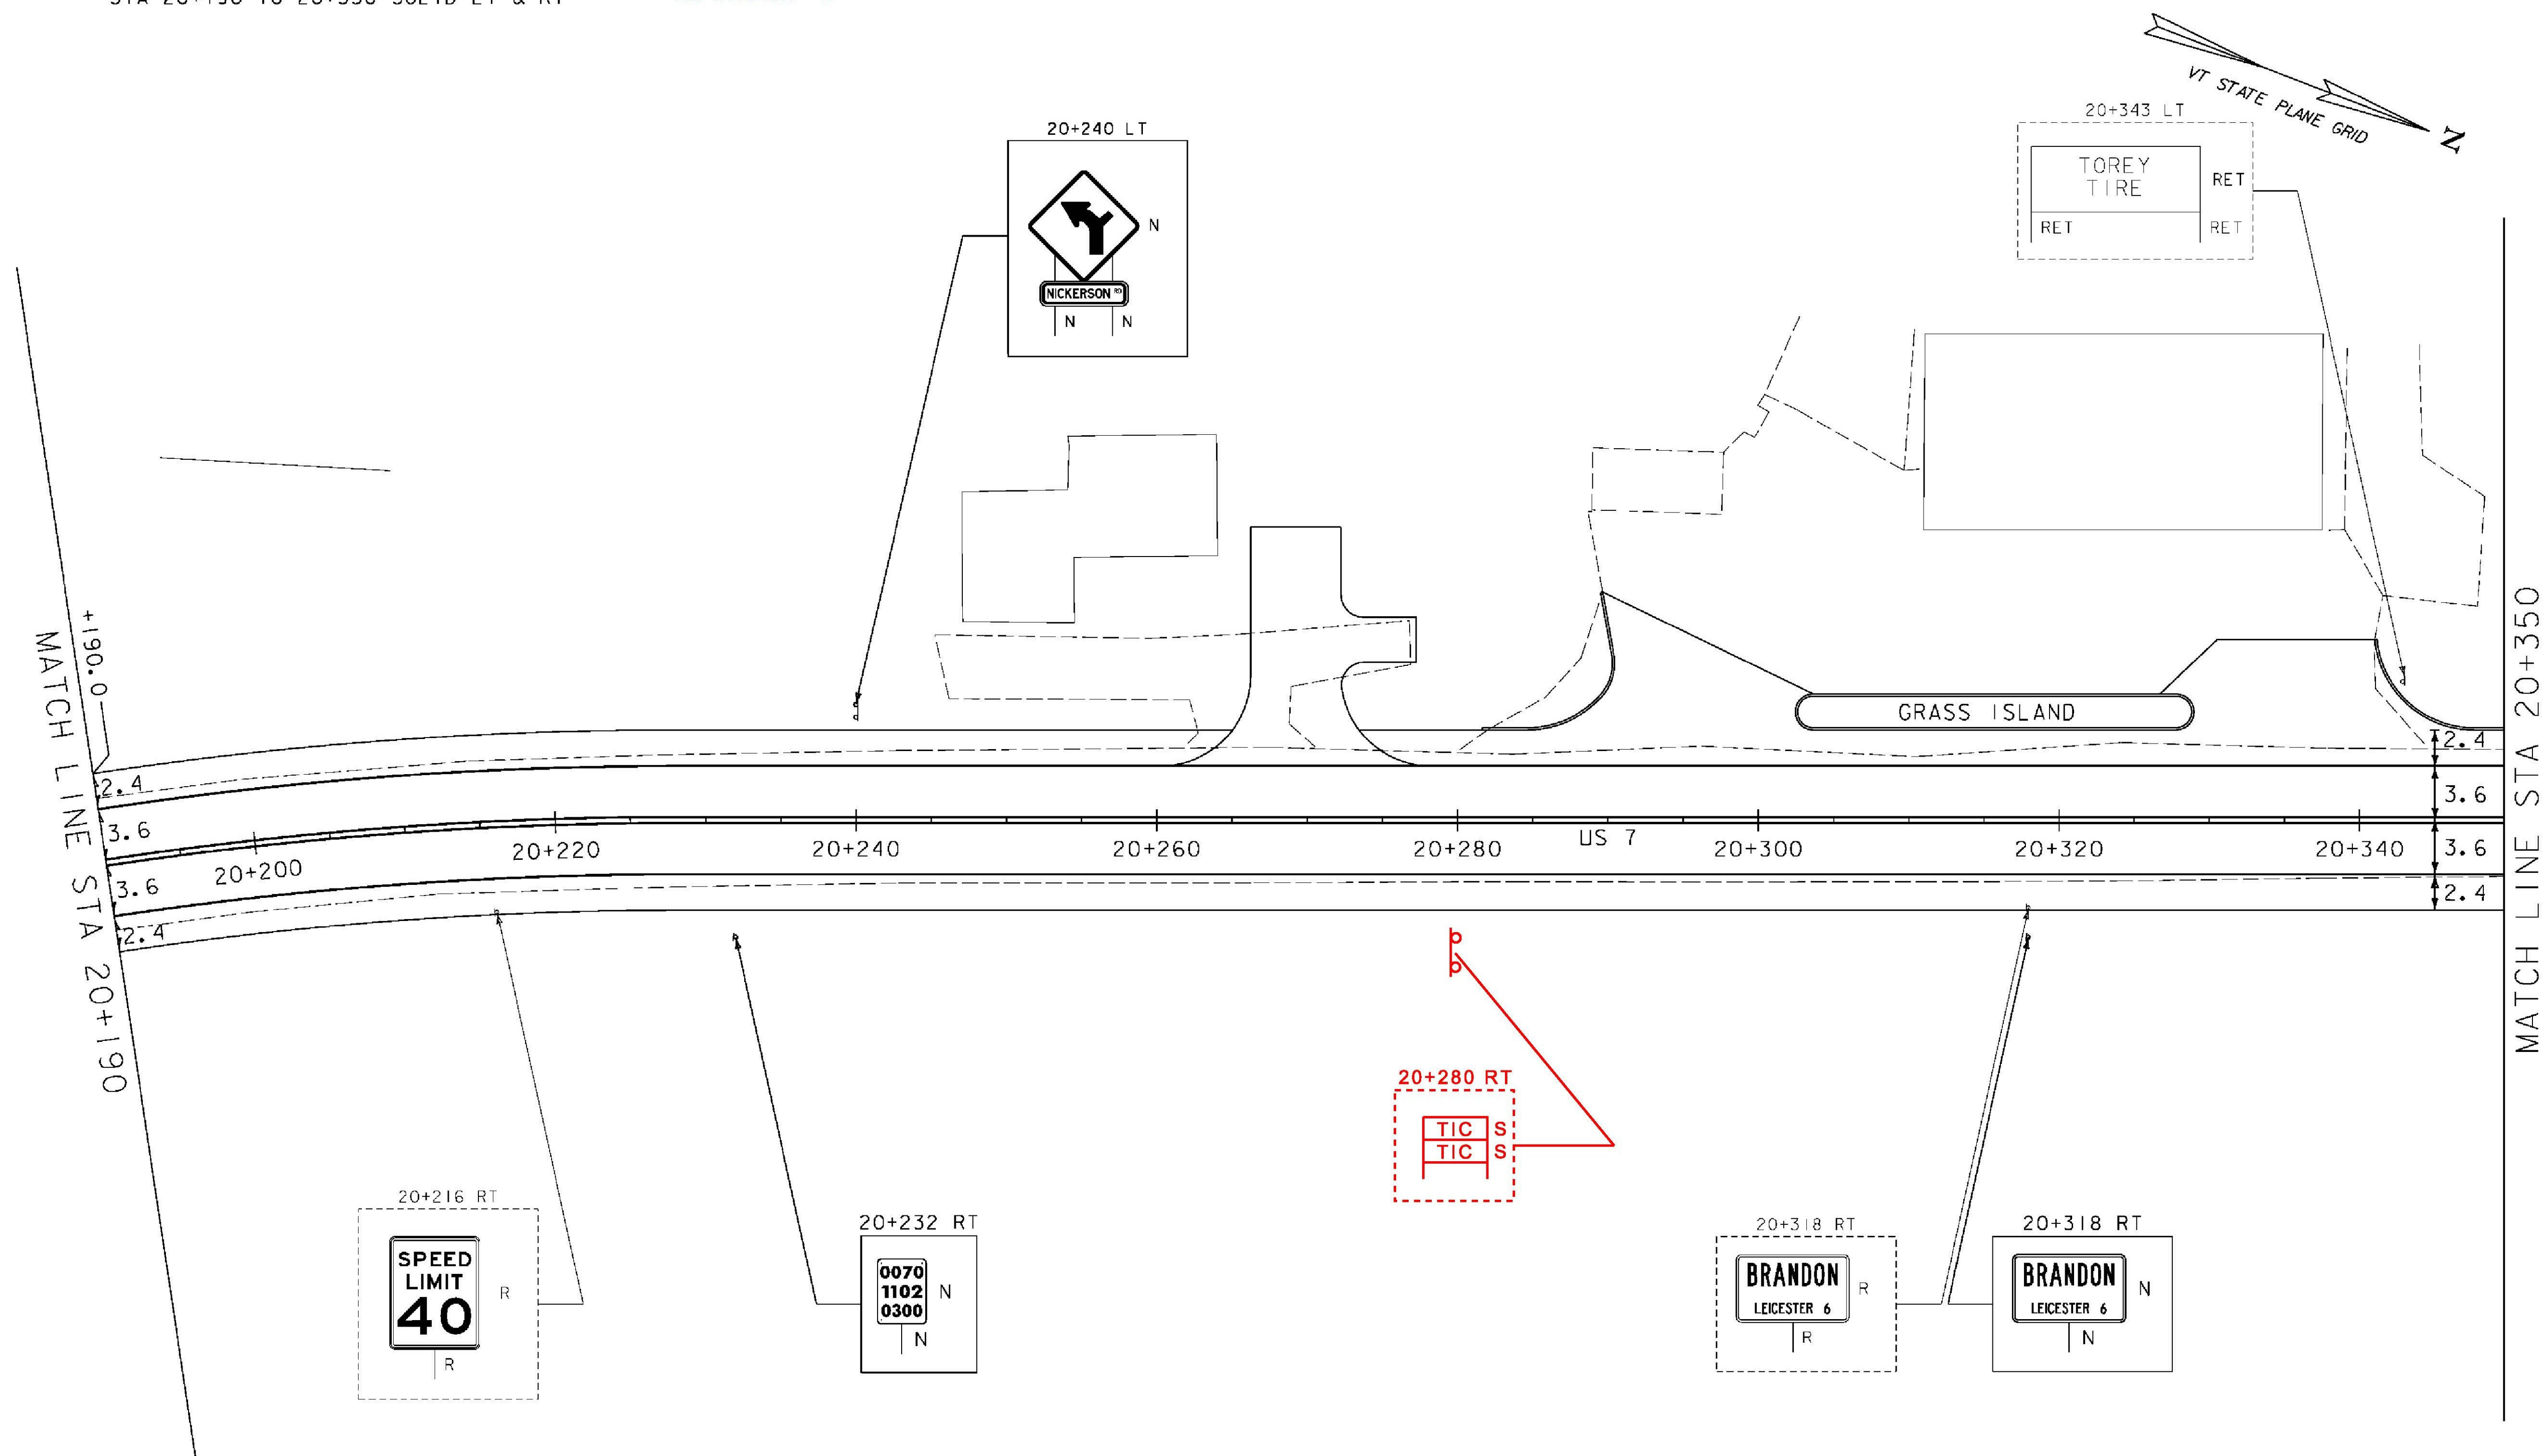

**SIGN LEGEND**

R = REMOVE  
 S = SALVAGE  
 N = NEW  
 RET = RETAIN  
 T&T = THINNING & TRIMMING  
 B-B = BACK TO BACK  
 EXISTING  
 NEW



**SIGNING & PAVEMENT MARKING 25**

PROJECT NAME: BRANDON  
 PROJECT NUMBER: NH 019-3(495)

FILE NAME: zb008s5-ts25.dgn  
 PROJECT LEADER: CRB  
 DESIGNED BY: NLL  
 CLD 02-0149

PLOT DATE: 9/3/2009  
 DRAWN BY: HJC  
 CHECKED BY: PTS  
 SHEET 266 OF 546