




TEMPORARY 100mm WHITE LINE, PAINT
 DURABLE 100mm WHITE LINE, THERMOPLASTIC
 STA 20+350 TO 20+510 SOLID LT & RT

TEMPORARY 100mm YELLOW LINE, PAINT
 DURABLE 100mm YELLOW LINE, THERMOPLASTIC
 STA 20+350 TO 20+510 SOLID LT & RT

REMOVING SIGNS
 AS SHOWN - 5

SALVAGED T.I.C.
 AS SHOWN - 3 1

SETTING SALVAGED POSTS
 AS SHOWN - 2

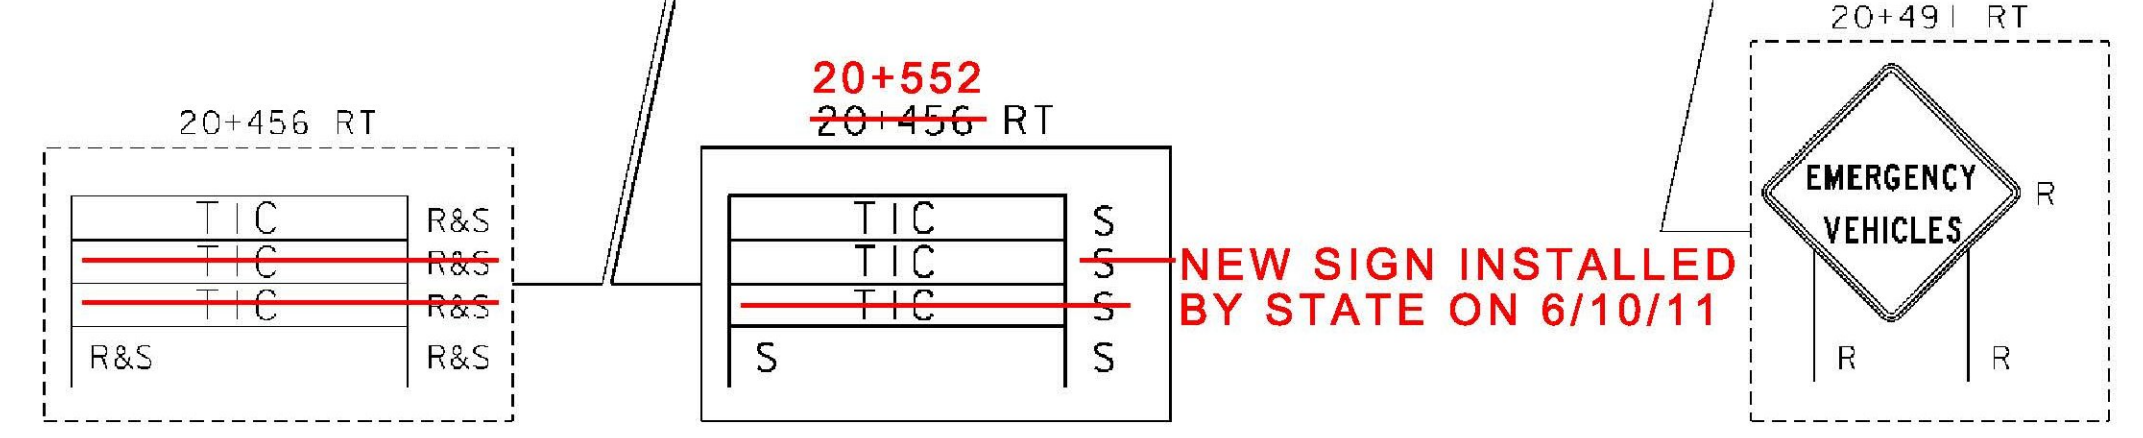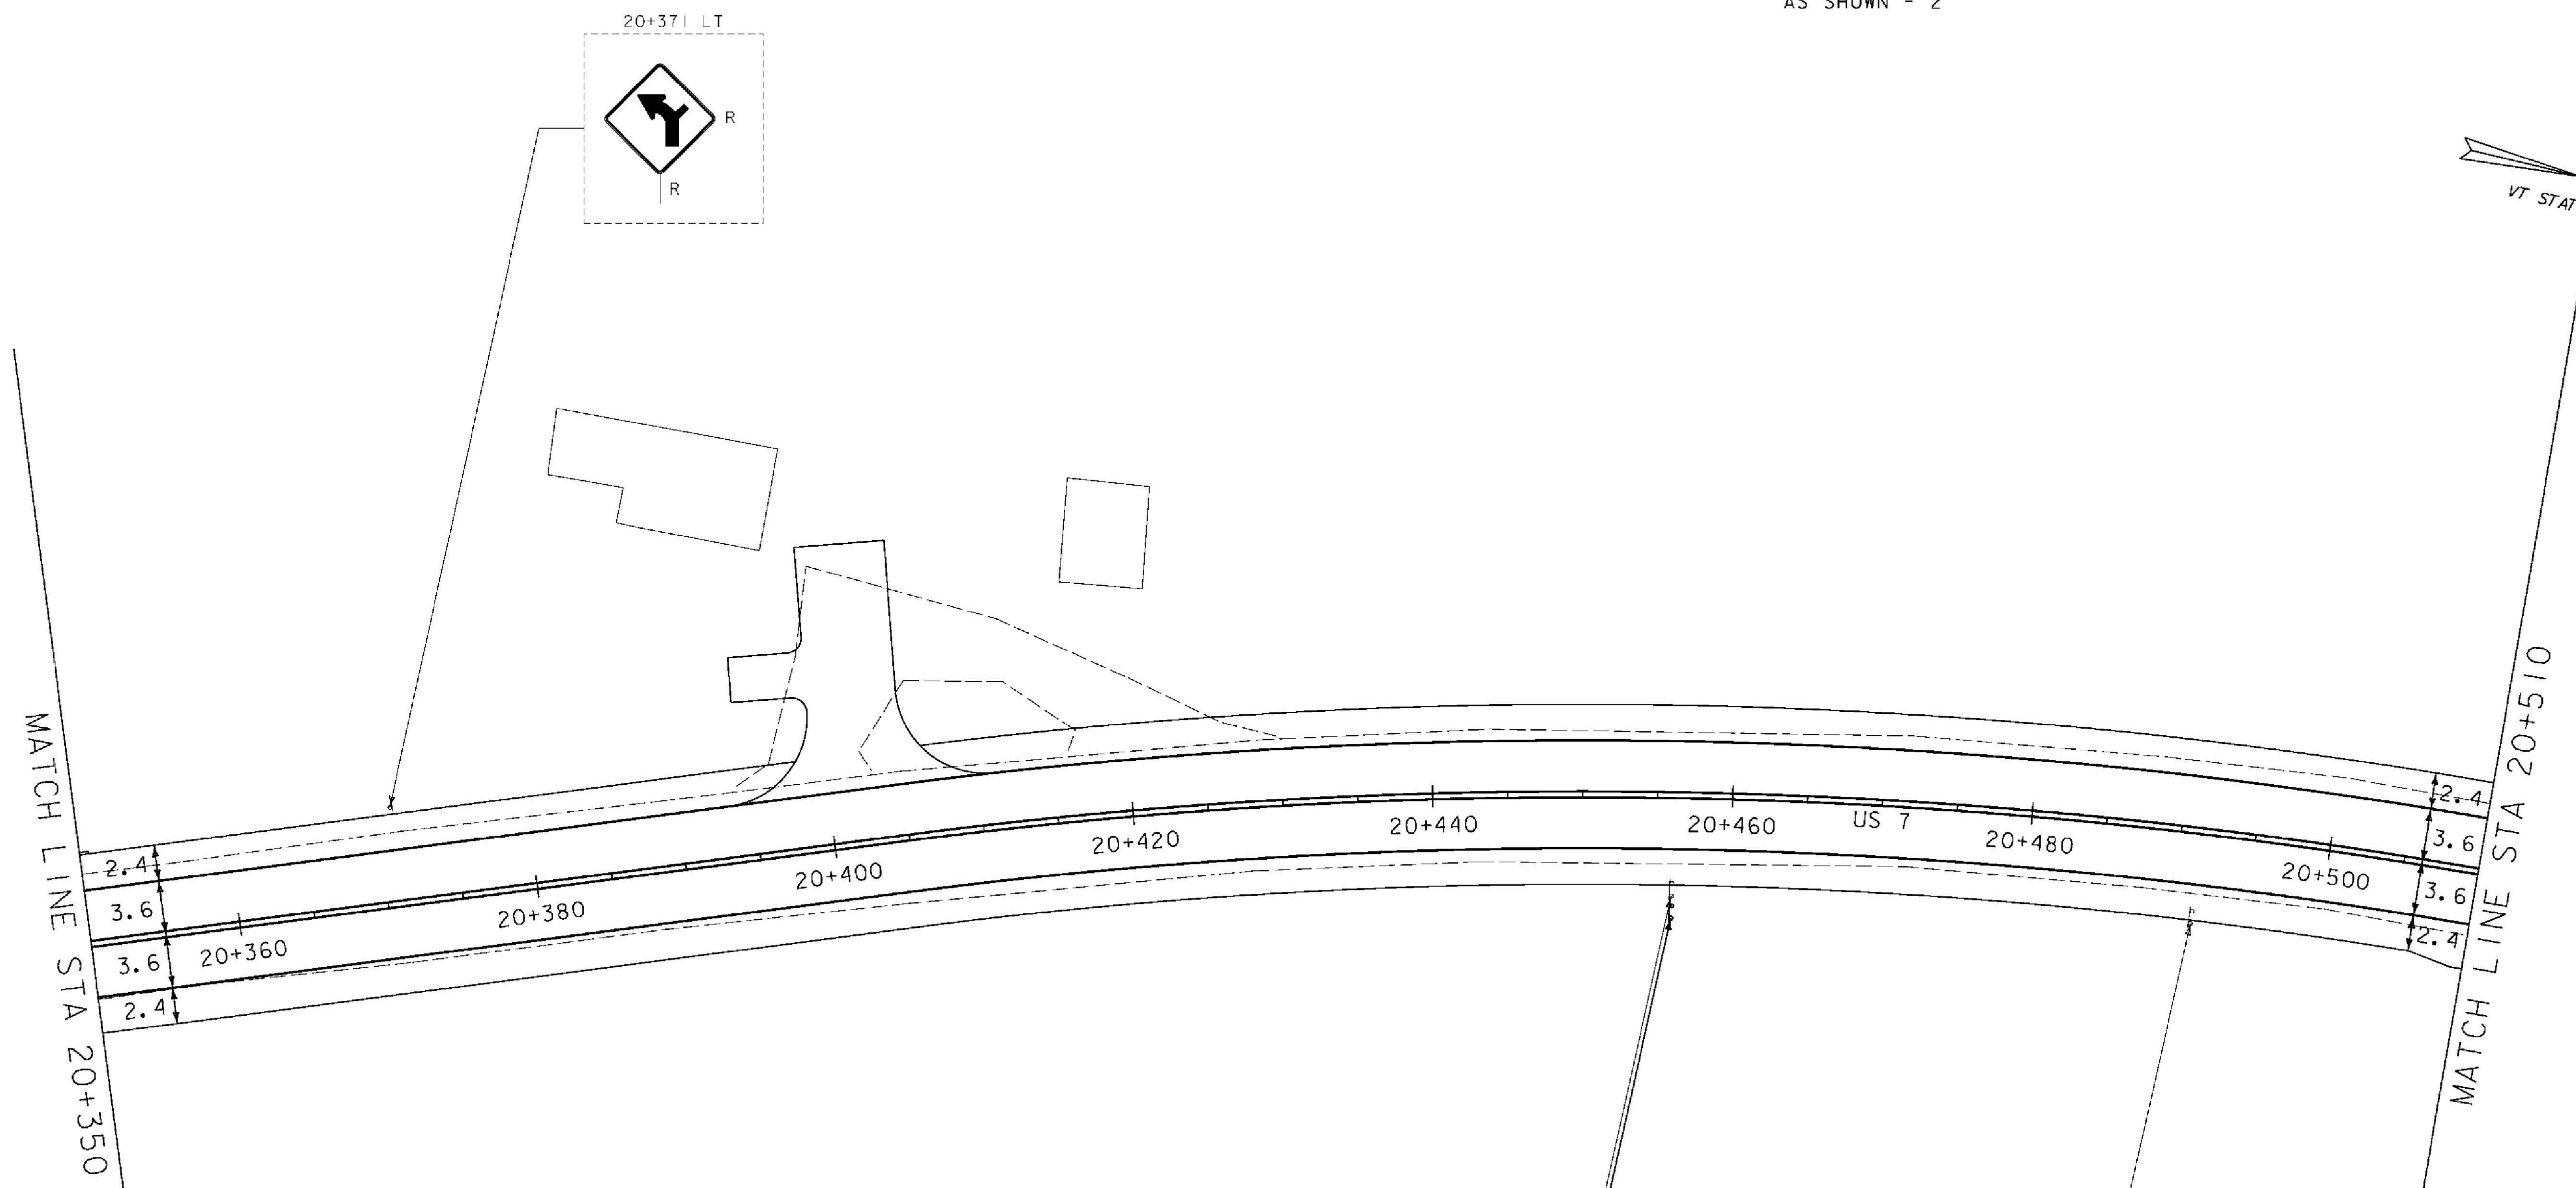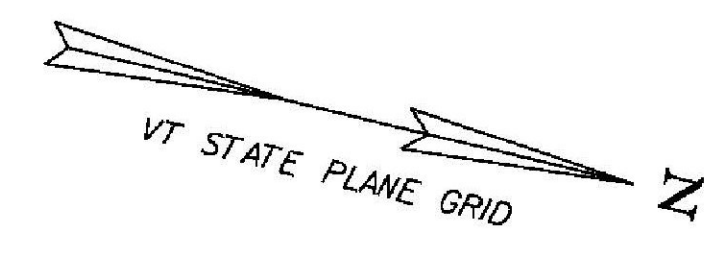

SIGN LEGEND

R = REMOVE
 S = SALVAGE
 N = NEW
 RET = RETAIN
 T&T = THINNING & TRIMMING
 B-B = BACK TO BACK
 EXISTING
 NEW



SIGNING & PAVEMENT MARKING 26

PROJECT NAME: BRANDON
 PROJECT NUMBER: NH 019-3(495)

FILE NAME: zb008s5-ts26.dgn
 PROJECT LEADER: CRB
 DESIGNED BY: NLL
 CLD 02-0149

PLOT DATE: 9/3/2009
 DRAWN BY: HJC
 CHECKED BY: PTS
 SHEET 267 OF 546