


TEMPORARY 100mm WHITE LINE, PAINT  
 DURABLE 100mm WHITE LINE, THERMOPLASTIC  
 STA 20+650 TO 20+820 SOLID LT & RT

TEMPORARY 100mm YELLOW LINE, PAINT  
 DURABLE 100mm YELLOW LINE, THERMOPLASTIC  
 STA 20+650 TO 20+820 SOLID LT & RT





REMOVING SIGNS  
 AS SHOWN - 11

ERECTING SALVAGED SIGNS  
 AS SHOWN - 2


STA 20+820.000 AHD  
 END APPROACH

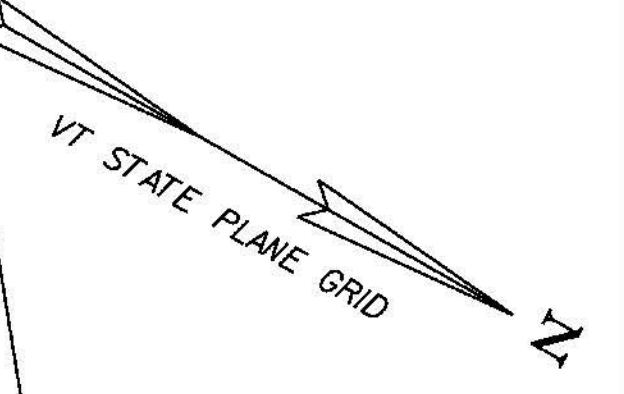

STA 20+777.617 BK  
 END PROJECT  
 NH 019-3(495)  
 BEGIN APPROACH

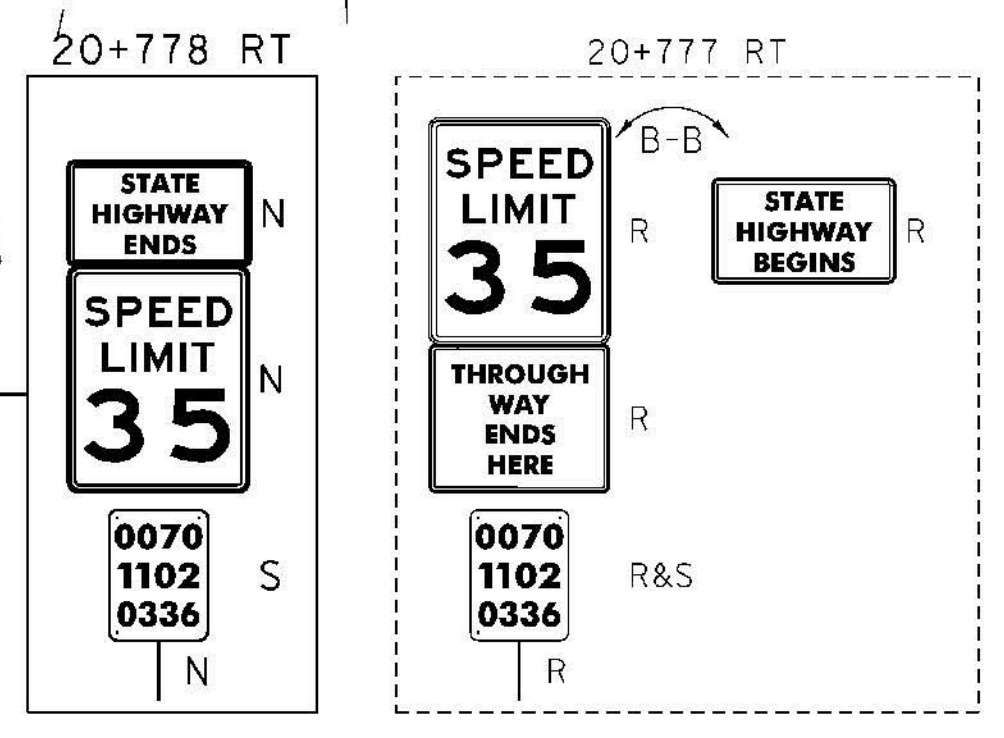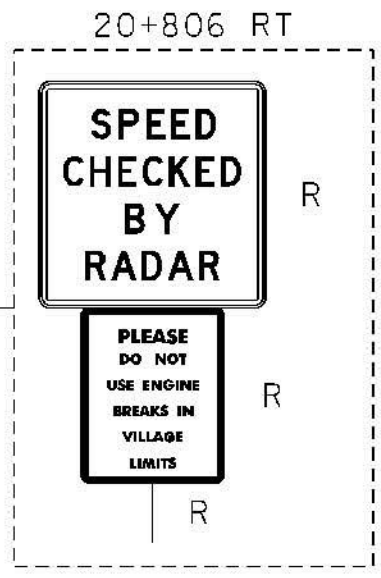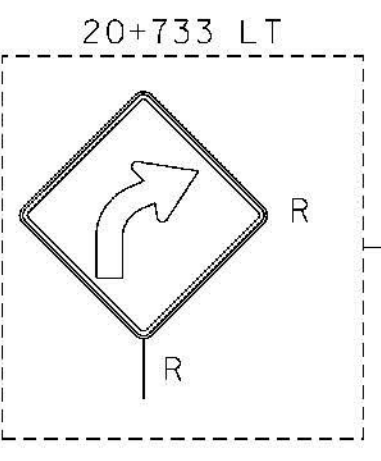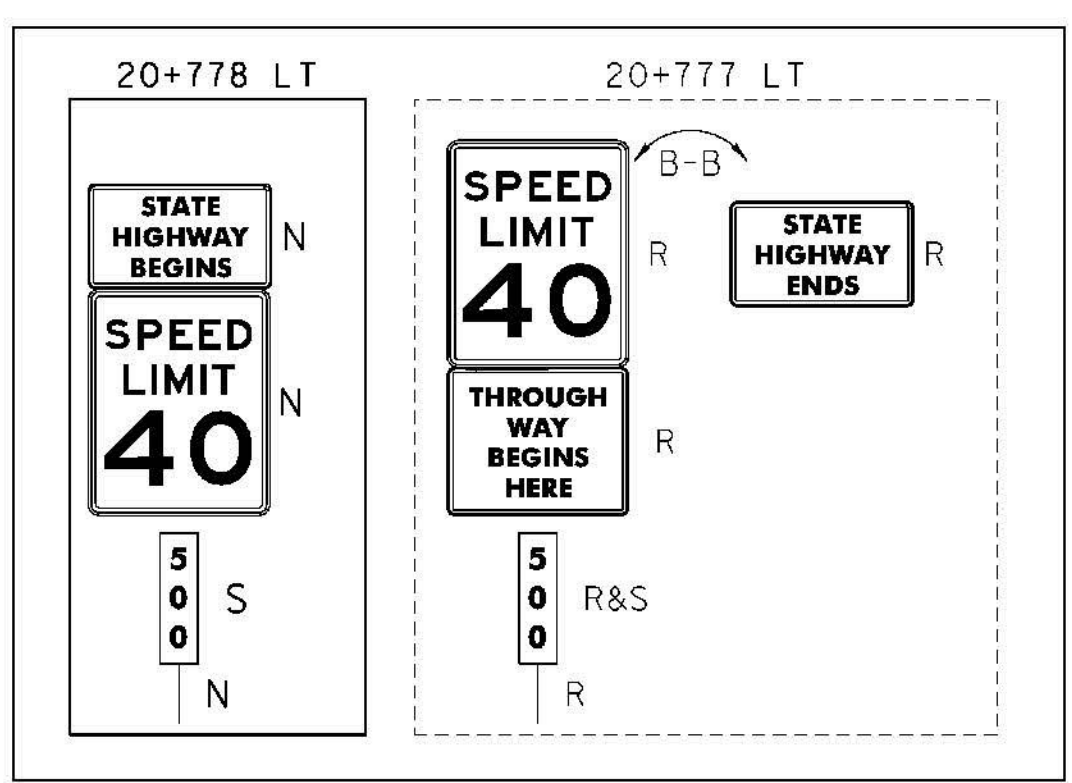

MATCH LINE STA 20+650

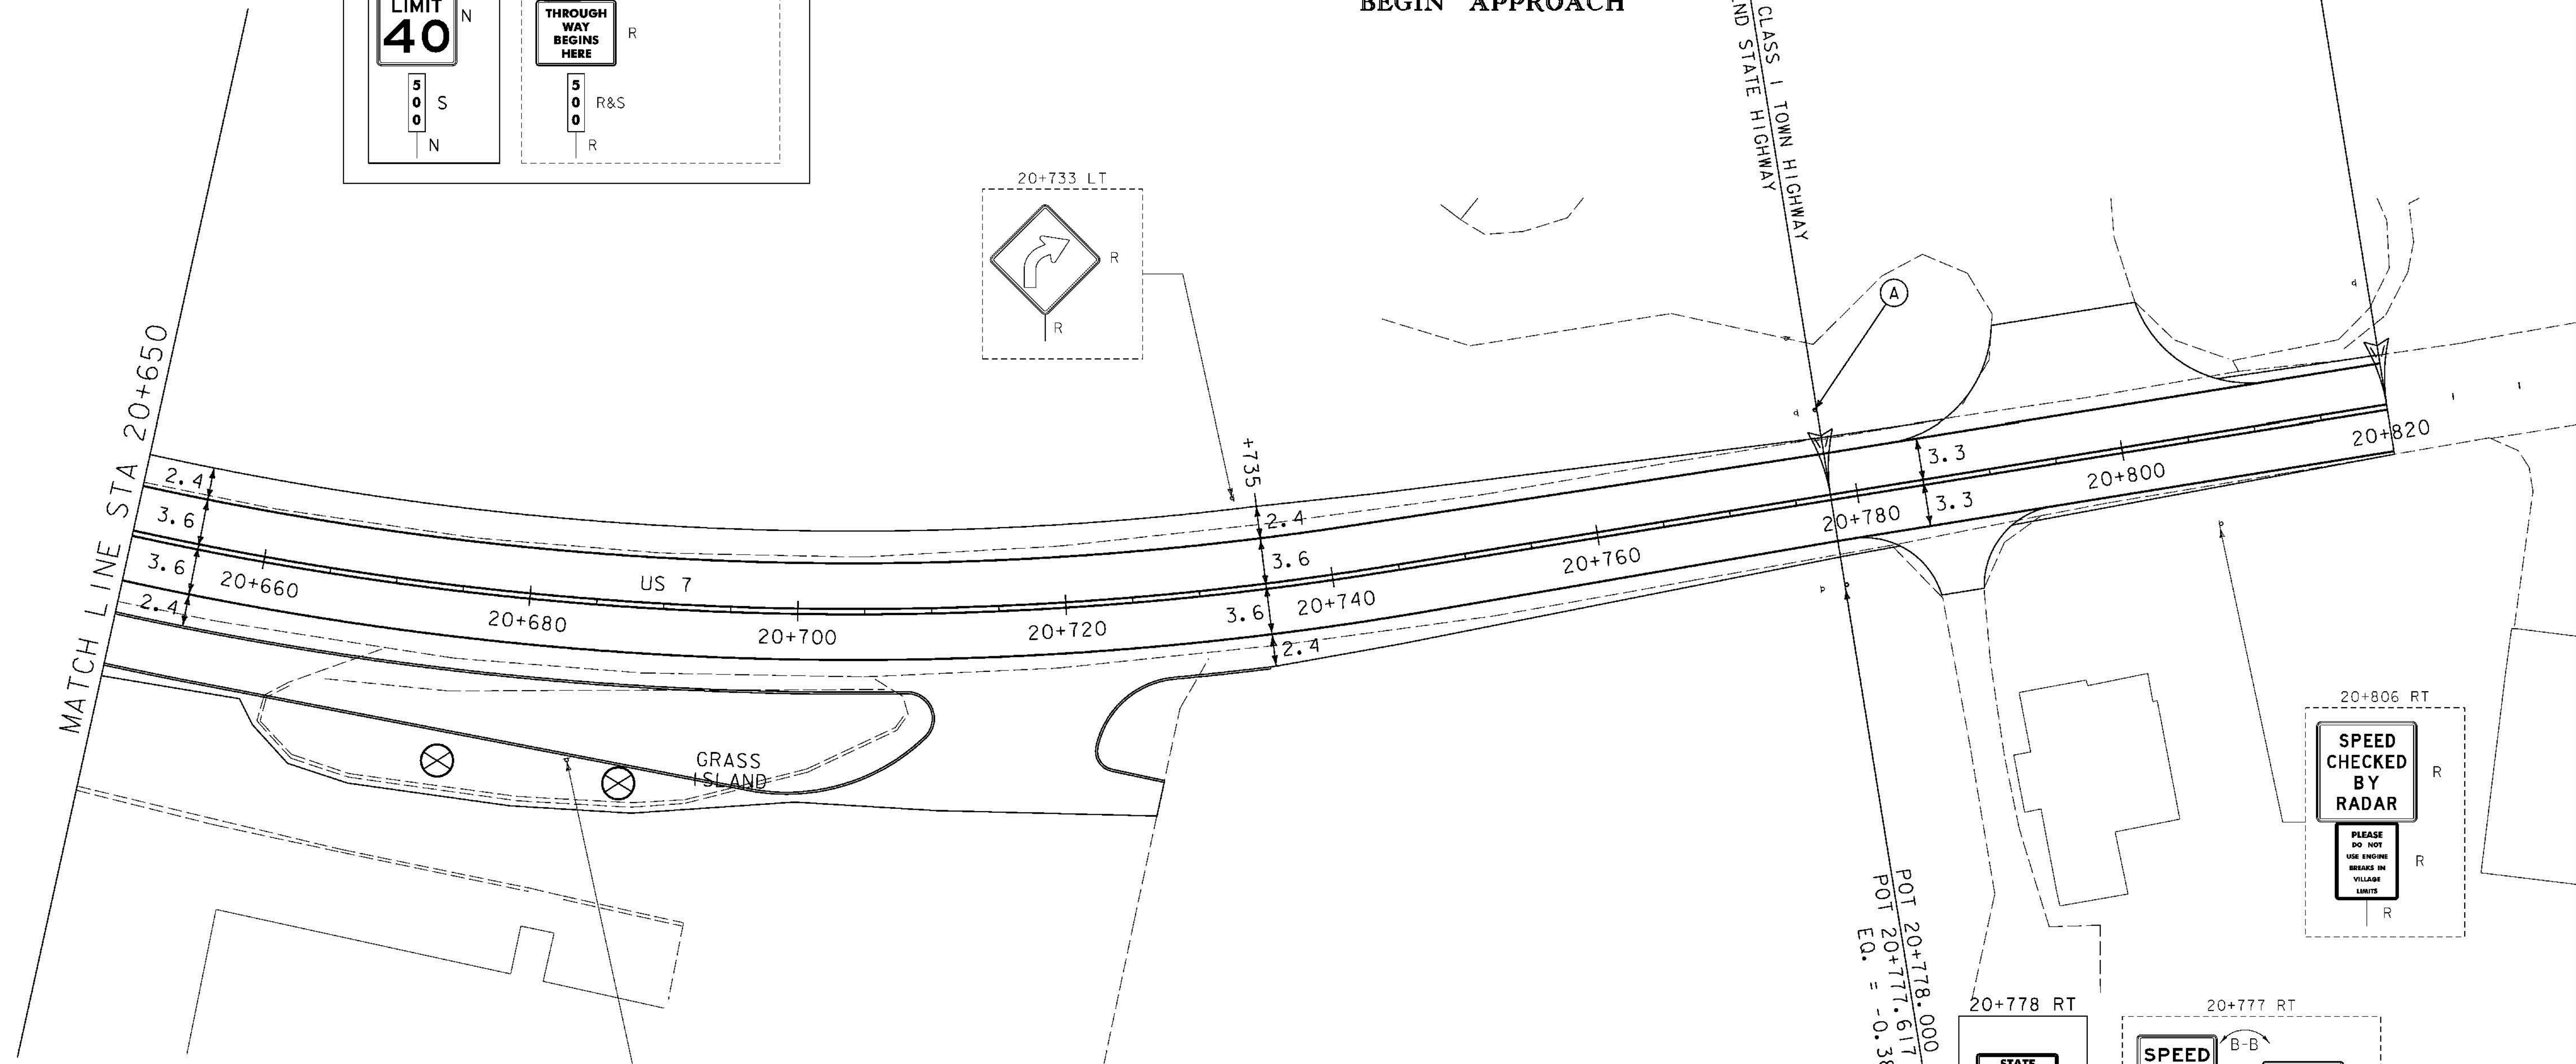

**SIGN LEGEND**

- R = REMOVE
- S = SALVAGE
- N = NEW
- RET = RETAIN
- T&T = THINNING & TRIMMING
- B-B = BACK TO BACK
- EXISTING =
- NEW =



**SIGNING & PAVEMENT MARKING 28**

PROJECT NAME: BRANDON	PLOT DATE: 9/3/2009
PROJECT NUMBER: NH 019-3(495)	DRAWN BY: HJC
FILE NAME: zb008s5-+s28.dgn	CHECKED BY: PTS
PROJECT LEADER: CRB	SHEET 269 OF 546
DESIGNED BY: NLL	
CLD 02-0149	