

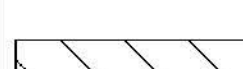

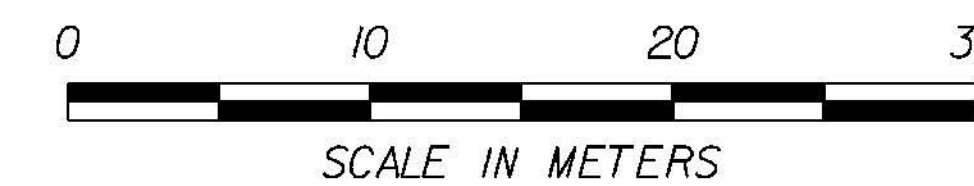


STA 17+720 RT
STOP TEMPORARY WIDENING
FOR PHASE II TRAFFIC

STA 17+150.0 LLT TO 17+162.7 LLT
TEMP. 375mm x 14m RCP CLASS IV
REMOVE WHEN NO LONGER NEEDED IV

LEGEND

-  PHASE I CONSTRUCTION
-  TEMPORARY WIDENING FOR PHASE I TRAFFIC
-  TEMPORARY WIDENING FOR PHASE II TRAFFIC
-  PHASE I TRAFFIC
- SSL SINGLE SOLID WHITE LINE
100mm WIDE (PAINT)
- DSL DOUBLE SOLID YELLOW LINE
100mm WIDE (PAINT)



PHASE I
TRAFFIC CONTROL PLAN 9

PROJECT NAME: BRANDON	PLOT DATE: 9/3/2009
PROJECT NUMBER: NH 019-3(495)	DRAWN BY: NLL
FILE NAME: zb008s5-+cp09.dgn	CHECKED BY: KLS
PROJECT LEADER: CRB	SHEET 290 OF 546
DESIGNED BY: PTS	
CLD 02-0149	