


MATCH LINE STA 17+790

MATCH LINE STA 17+950

LEGEND	
	PHASE I CONSTRUCTION
	TEMPORARY WIDENING FOR PHASE I TRAFFIC
	TEMPORARY WIDENING FOR PHASE II TRAFFIC
	PHASE I TRAFFIC
	SSL SINGLE SOLID WHITE LINE 100mm WIDE (PAINT)
	DSL DOUBLE SOLID YELLOW LINE 100mm WIDE (PAINT)

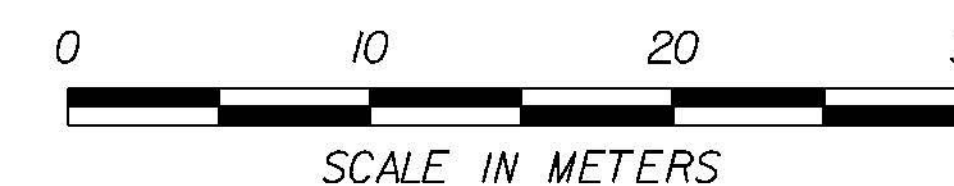

PHASE I  
TRAFFIC CONTROL PLAN 10

PROJECT NAME: BRANDON	PLOT DATE: 9/3/2009
PROJECT NUMBER: NH 019-3(495)	DRAWN BY: NLL
FILE NAME: zb008s5+tcp10.dgn	CHECKED BY: KLS
PROJECT LEADER: CRB	SHEET 291 OF 546
DESIGNED BY: PTS	
CLD 02-0149	