


MATCH LINE STA 17+950

MATCH LINE STA 18+110



LEGEND	
	PHASE II CONSTRUCTION
	PHASE II TRAFFIC
	SSL SINGLE SOLID WHITE LINE 100mm WIDE (TYPE II TAPE)
	DSL DOUBLE SOLID YELLOW LINE 100mm WIDE (TYPE II TAPE)

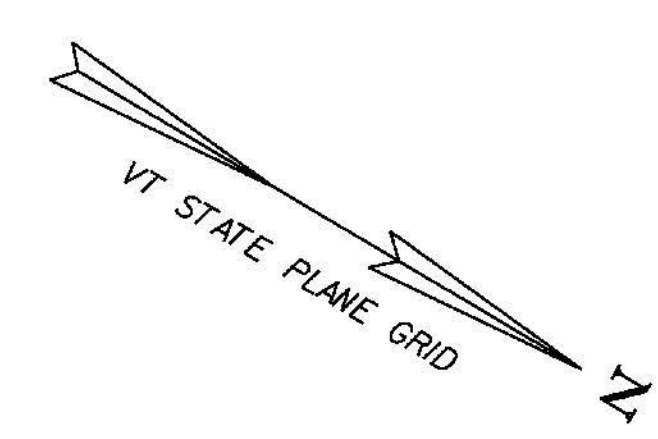

PHASE II  
TRAFFIC CONTROL PLAN II

PROJECT NAME: BRANDON	PLOT DATE: 9/3/2009
PROJECT NUMBER: NH 019-3(495)	DRAWN BY: NLL
FILE NAME: zb008s5+tcp39.dgn	CHECKED BY: KLS
PROJECT LEADER: CRB	SHEET 320 OF 546
DESIGNED BY: PTS	
CLD 02-0149	