


STA 18+300
END ALTERNATING ONE-WAY TRAFFIC

STA 18+300
RESUME PHASED CONSTRUCTION WITH TWO-WAY TRAFFIC

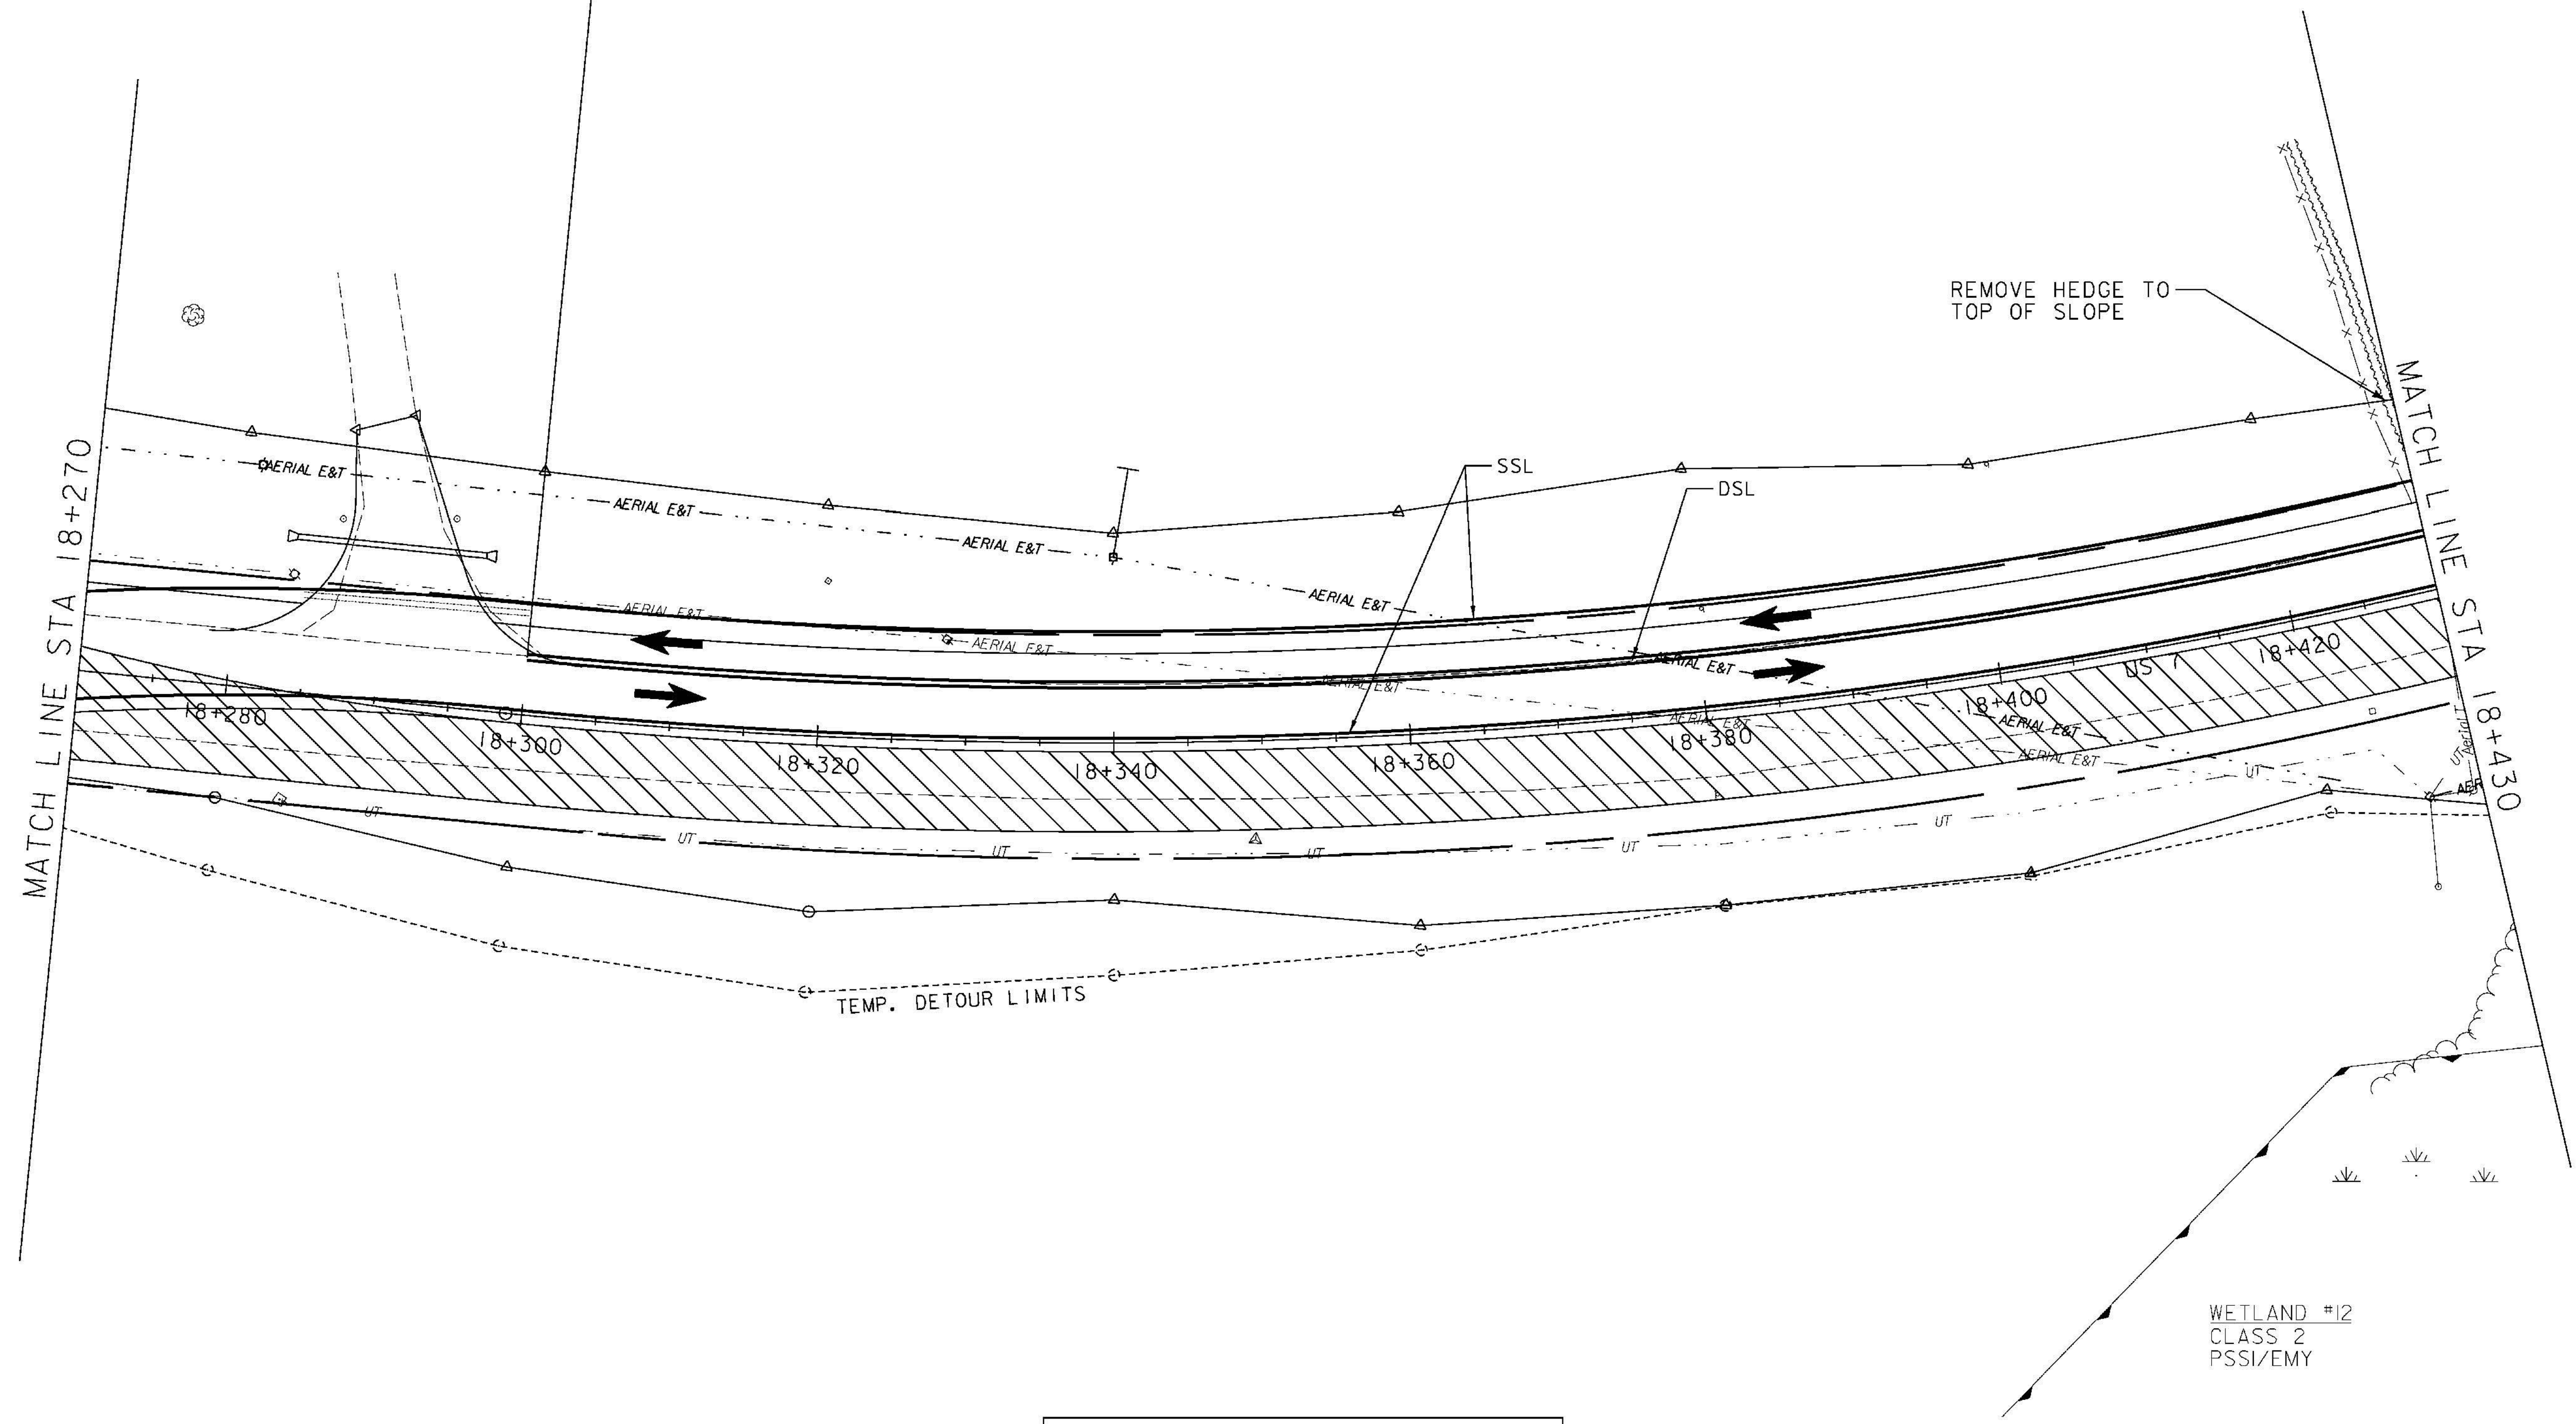

WETLAND #12
CLASS 2
PSSI/EMY

LEGEND	
	PHASE II CONSTRUCTION
	PHASE II TRAFFIC
SSL	SINGLE SOLID WHITE LINE 100mm WIDE (TYPE II TAPE)
DSL	DOUBLE SOLID YELLOW LINE 100mm WIDE (TYPE II TAPE)



PHASE II
TRAFFIC CONTROL PLAN 13

PROJECT NAME: BRANDON	PLOT DATE: 9/3/2009
PROJECT NUMBER: NH 019-3(495)	DRAWN BY: NLL
FILE NAME: zb008s5+tcp41.dgn	CHECKED BY: KLS
PROJECT LEADER: CRB	SHEET 322 OF 546
DESIGNED BY: PTS	
CLD 02-0149	