
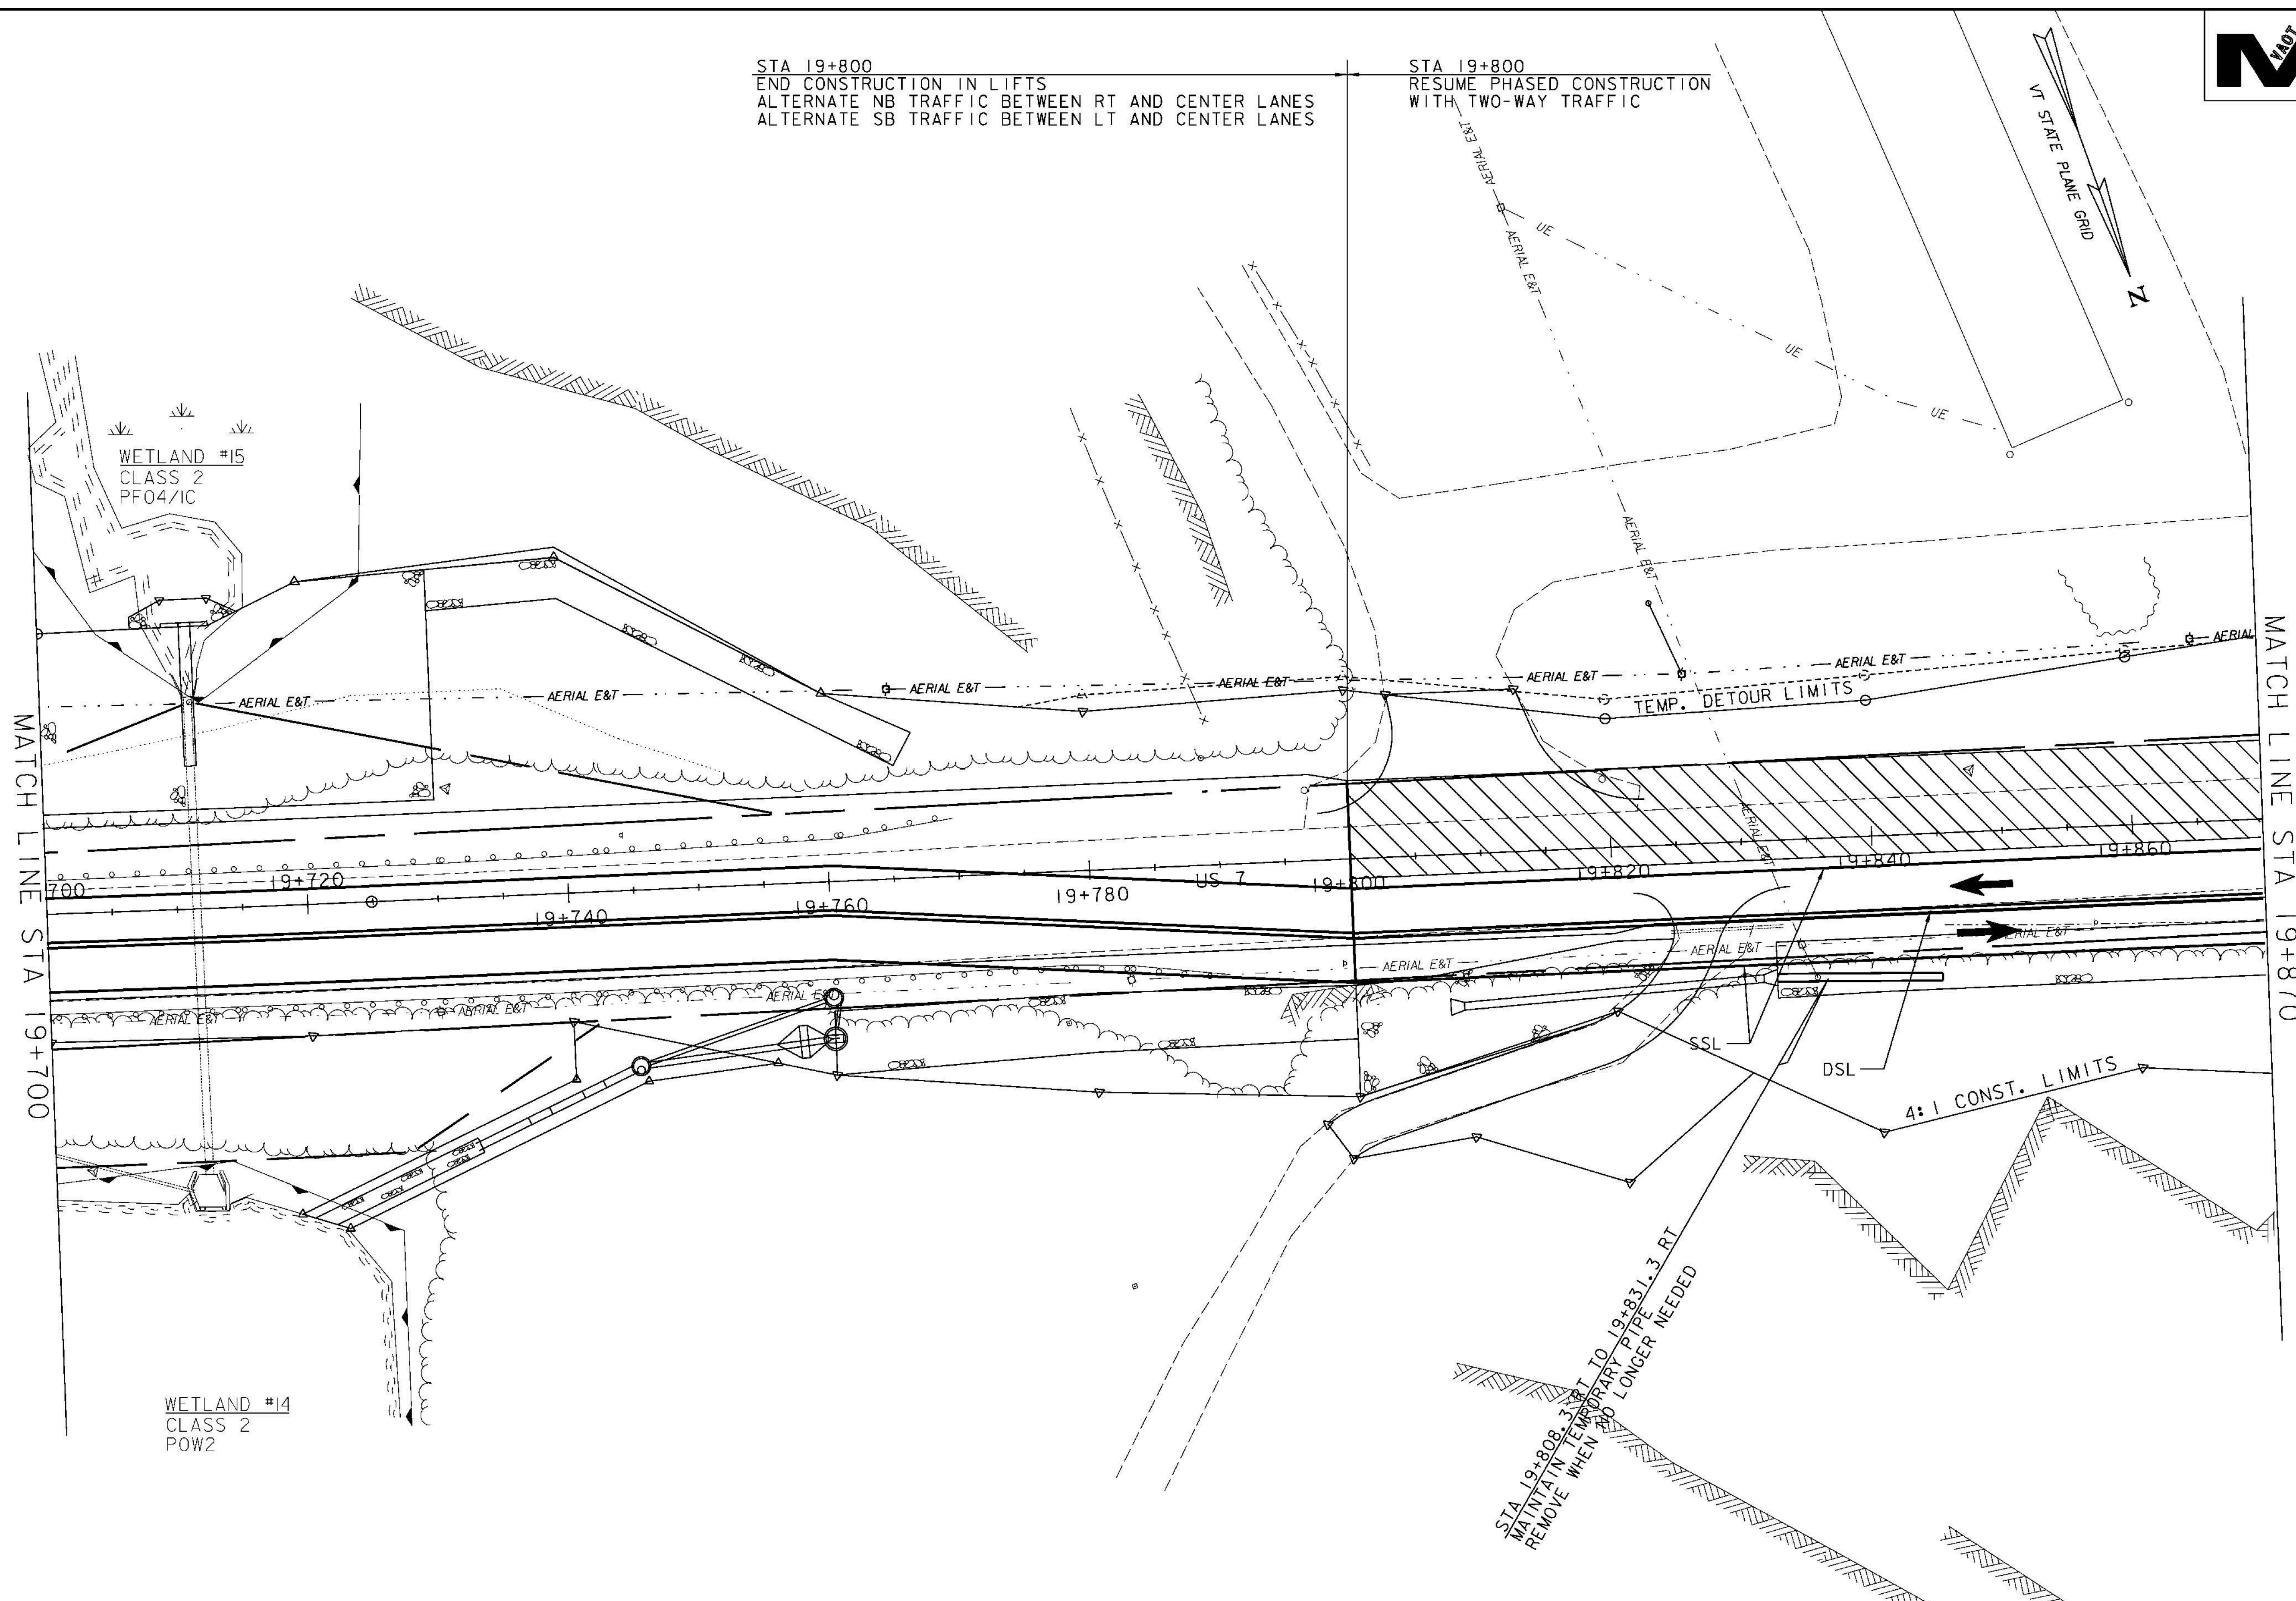


STA 19+800
 END CONSTRUCTION IN LIFTS
 ALTERNATE NB TRAFFIC BETWEEN RT AND CENTER LANES
 ALTERNATE SB TRAFFIC BETWEEN LT AND CENTER LANES

STA 19+800
 RESUME PHASED CONSTRUCTION
 WITH TWO-WAY TRAFFIC

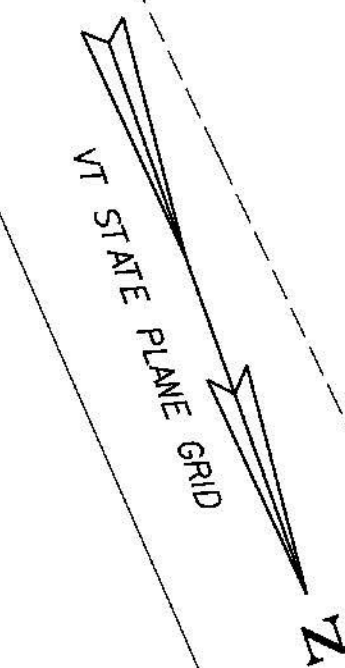

MATCH LINE STA 19+700


MATCH LINE STA 19+870

WETLAND #15
 CLASS 2
 PF04/1C

WETLAND #14
 CLASS 2
 POW2

STA 19+808.3
 MAINTAIN TEMPORARY P/T PE
 REMOVE WHEN NO LONGER NEEDED

LEGEND	
	PHASE II CONSTRUCTION
	PHASE II TRAFFIC
	SSL SINGLE SOLID WHITE LINE 100mm WIDE (TYPE II TAPE)
	DSL DOUBLE SOLID YELLOW LINE 100mm WIDE (TYPE II TAPE)

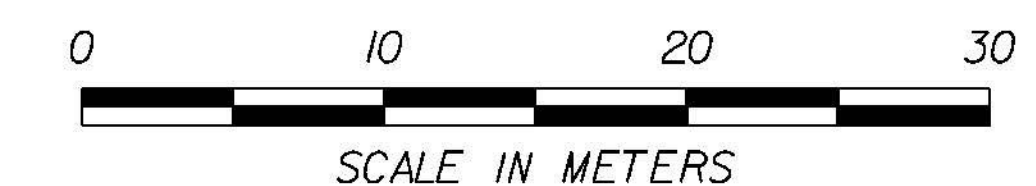

PHASE II
 TRAFFIC CONTROL PLAN 22

PROJECT NAME: BRANDON	PLOT DATE: 9/3/2009
PROJECT NUMBER: NH 019-3(495)	DRAWN BY: NLL
FILE NAME: zb008s5+tcp50.dgn	CHECKED BY: KLS
PROJECT LEADER: CRB	SHEET 331 OF 546
DESIGNED BY: PTS	
CLD 02-0149	