

**STA 20+820.000 AHD  
END APPROACH**

**STA 20+777.617 BK  
END PROJECT  
NH 019-3(495)  
BEGIN APPROACH**

STA 20+820.0  
END PHASE II CONSTRUCTION

STA 20+730.0 LT  
MAINTAIN TEMPORARY COVER ON CB


STA 20+780.0 LT  
MAINTAIN TEMPORARY  
COVER ON CB

BEGIN CLASS I TOWN HIGHWAY  
END STATE HIGHWAY

1:1 CONST. LIMITS

TEMP. DETOUR LIMITS

MATCH LINE STA 20+650

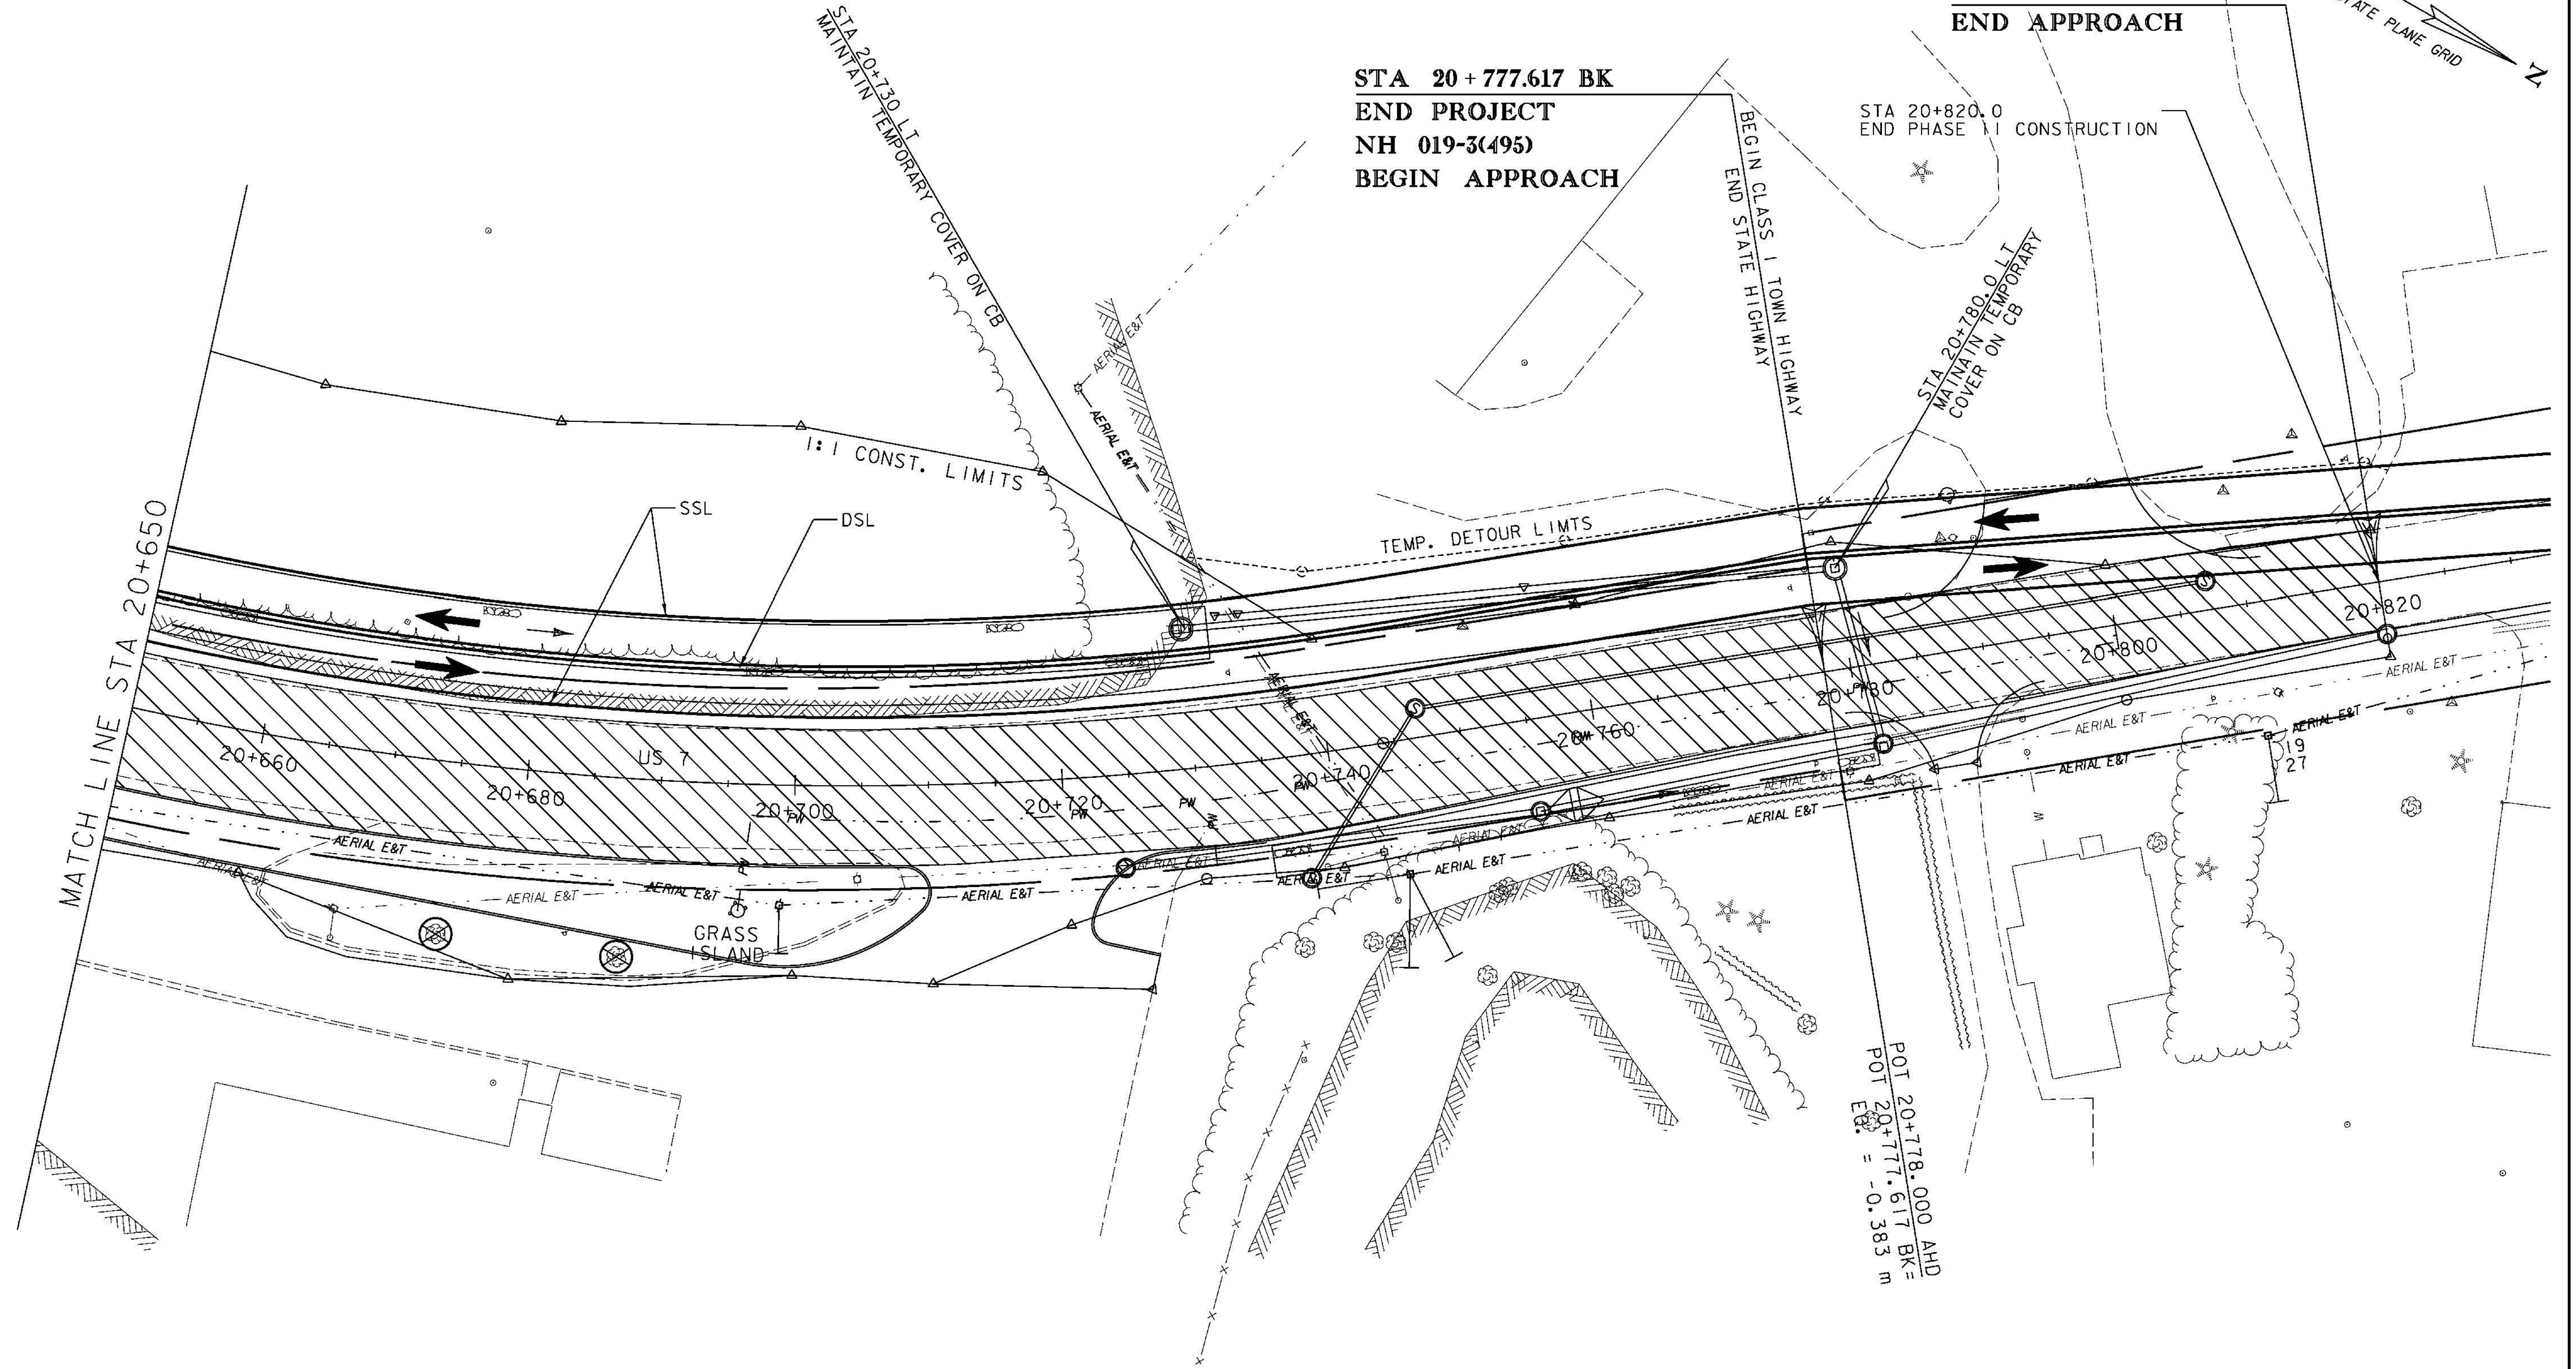

POT 20+778.000 AHD  
POT 20+777.617 BK =  
Eg. = -0.383 m

LEGEND	
	PHASE II CONSTRUCTION
	PHASE II TRAFFIC
	SSL SINGLE SOLID WHITE LINE 100mm WIDE (TYPE II TAPE)
	DSL DOUBLE SOLID YELLOW LINE 100mm WIDE (TYPE II TAPE)



**PHASE II  
TRAFFIC CONTROL PLAN 28**

PROJECT NAME: BRANDON	PLOT DATE: 9/3/2009
PROJECT NUMBER: NH 019-3(495)	DRAWN BY: NLL
FILE NAME: zb008s5-top56.dgn	CHECKED BY: KLS
PROJECT LEADER: CRB	SHEET 337 OF 546
DESIGNED BY: PTS	
CLD 02-0149	