



MATCH LINE STA 18+590

MATCH LINE STA 18+750

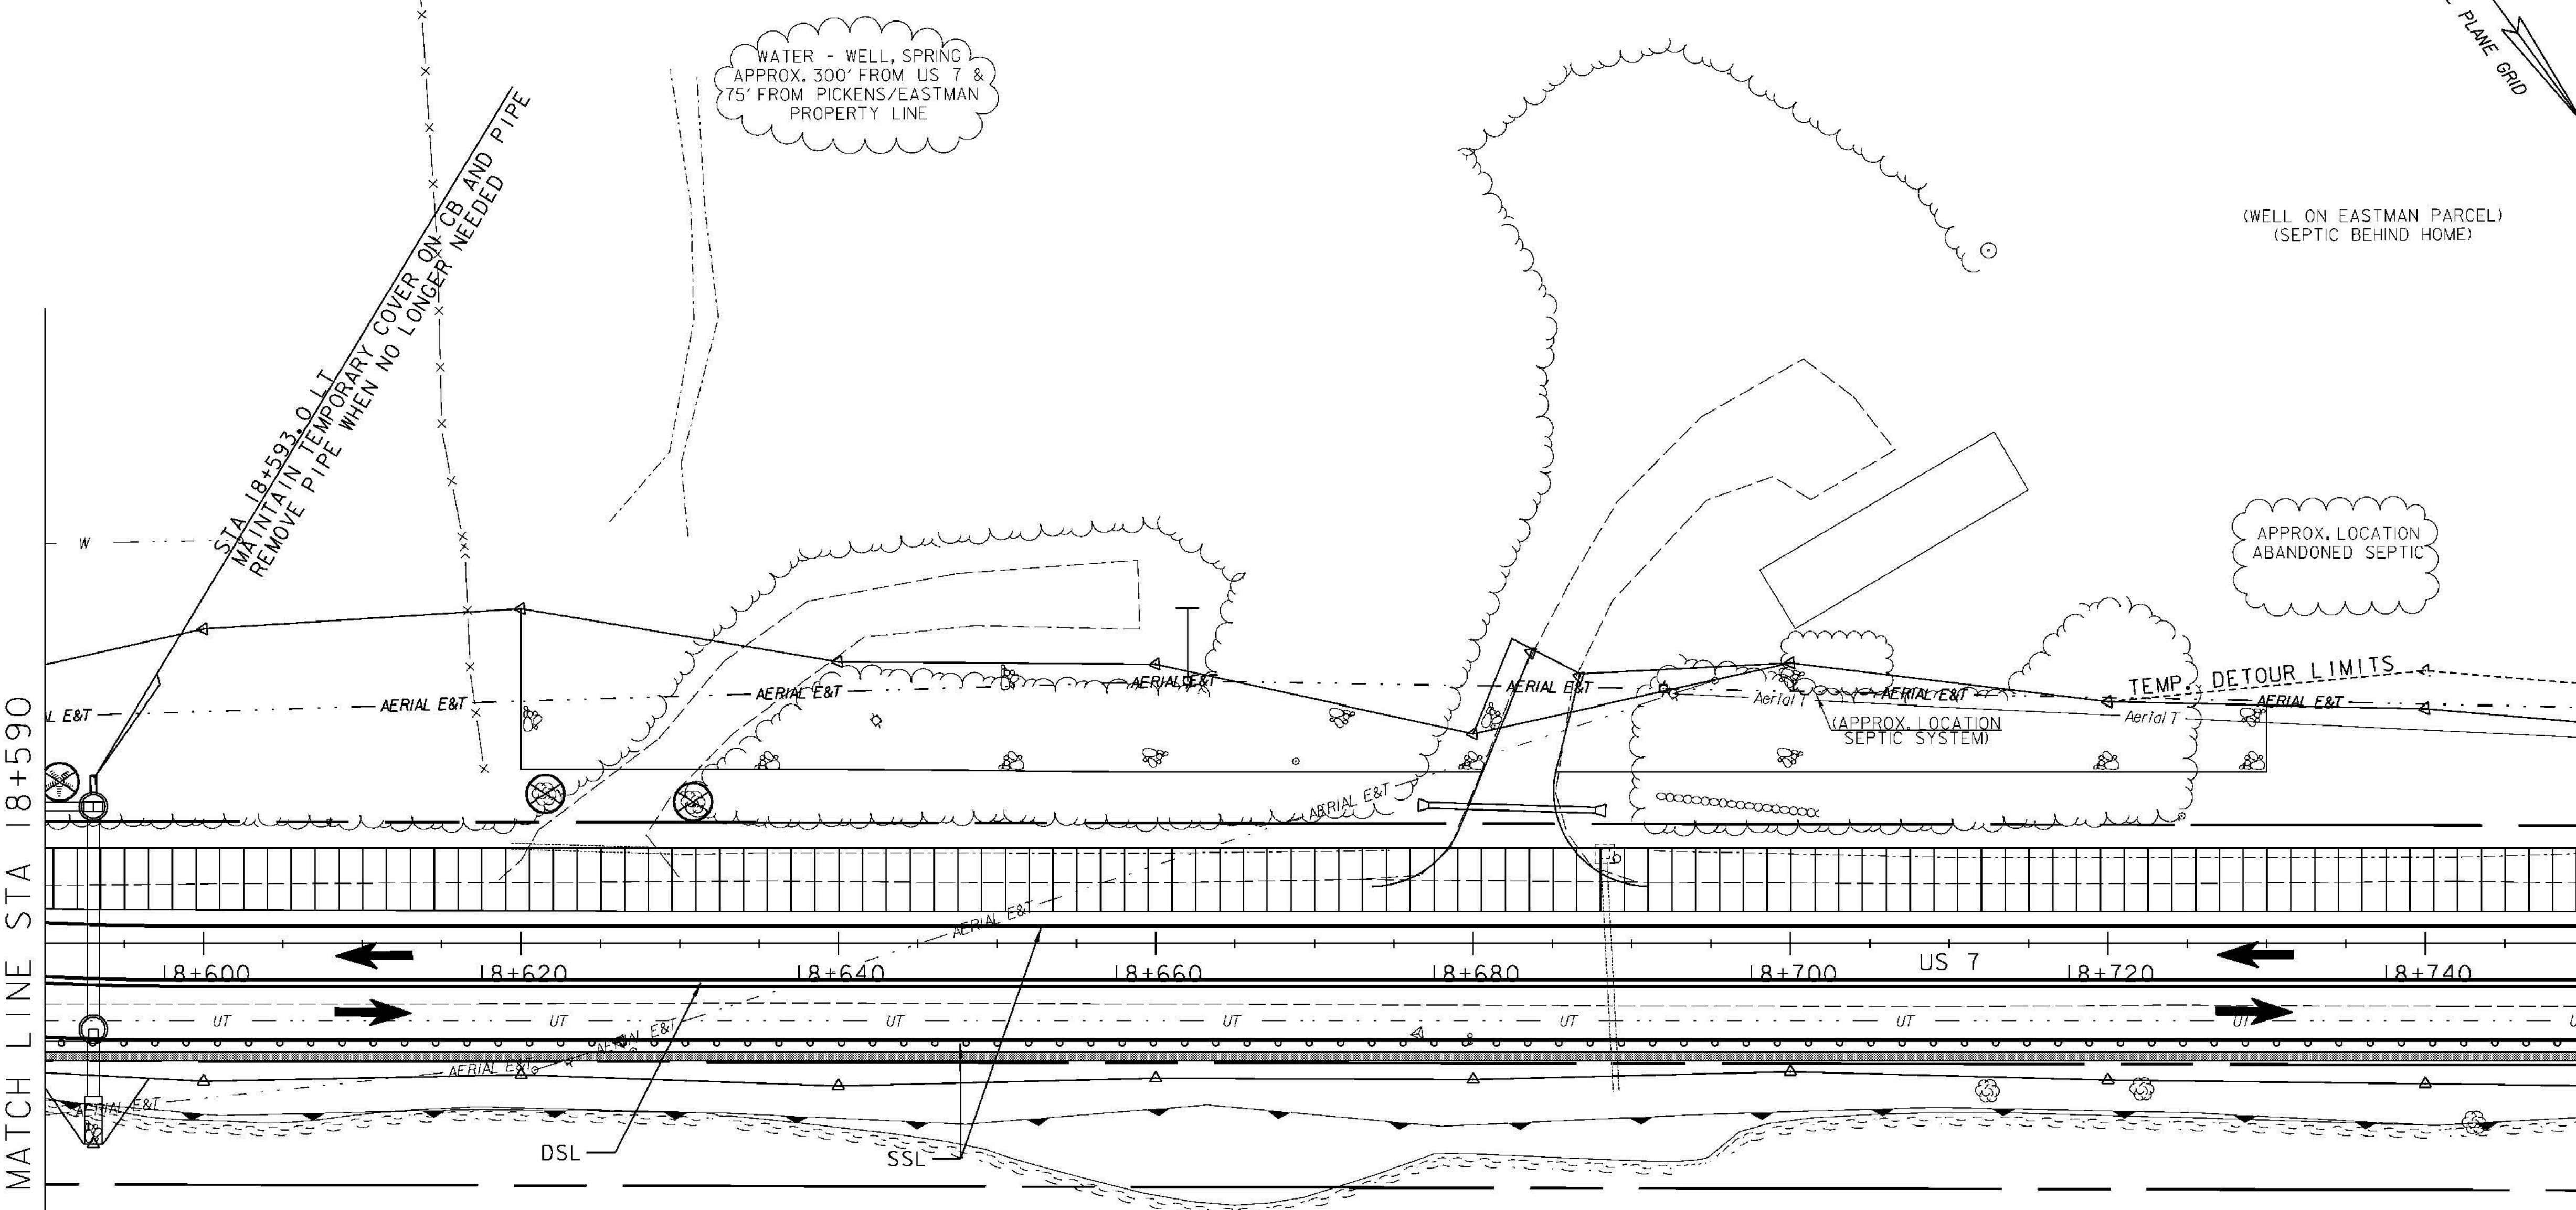

WETLAND #12  
CLASS 2  
PSS/EMY

LEGEND	
	PHASE III CONSTRUCTION
	PHASE III TRAFFIC
	SSL SINGLE SOLID WHITE LINE 100mm WIDE (PAINT)
	DSL DOUBLE SOLID YELLOW LINE 100mm WIDE (PAINT)

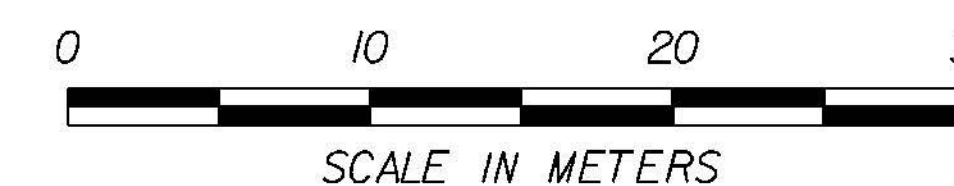

PHASE III  
TRAFFIC CONTROL PLAN 2

PROJECT NAME: BRANDON	PLOT DATE: 9/3/2009
PROJECT NUMBER: NH 019-3(495)	DRAWN BY: NLL
FILE NAME: zb008s5-+cpPH3-02.dgn	CHECKED BY: KLS
PROJECT LEADER: CRB	SHEET 339 OF 546
DESIGNED BY: PTS	
CLD 02-0149	