


16+420.0
MATCH EXISTING

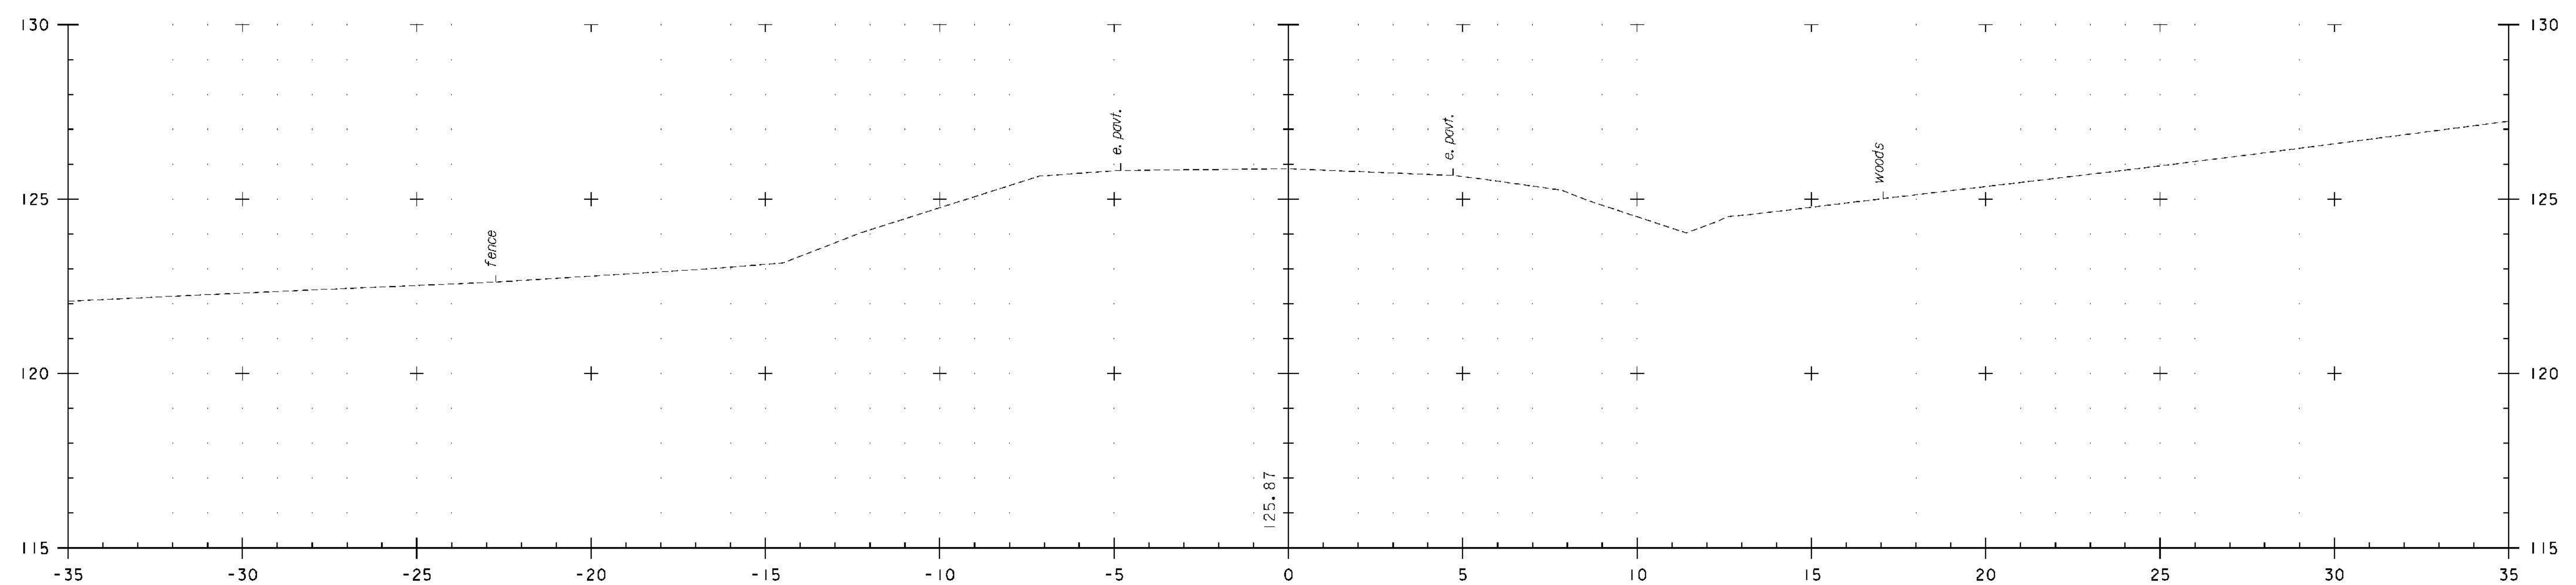

16+400.0

US 7

NOTE
1. EXISTING GROUND ELEVATION IS SHOWN LIGHT.
2. FINISH GRADE ELEVATION IS SHOWN IN BOLD.



PROJECT NAME:	BRANDON	PLOT DATE:	9/3/2009
PROJECT NUMBER:	NH 019-3(495)	DRAWN BY:	NLL
FILE NAME:	zb008s5-xs003.dgn	CHECKED BY:	DAM
PROJECT LEADER:	CRB	SHEET	384 OF 546
DESIGNED BY:	PTS		
CLD 02-0149			