


POC 16+460.474 BK
 POC 16+460.000 AHD
 EQ. = +0.474 m

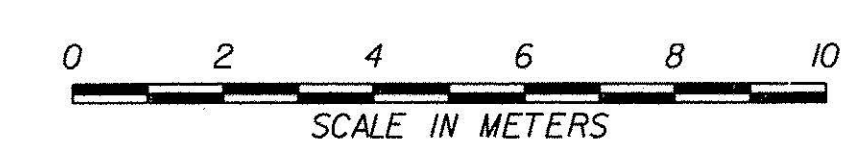

PROJECT NAME: BRANDON	FILE NAME: zb008s5-xs005.dgn	PLOT DATE: 9/3/2009
PROJECT NUMBER: NH 019-3(495)	PROJECT LEADER: CRB	DRAWN BY: NLL
	DESIGNED BY: PTS	CHECKED BY: DAM
	CLD 02-0149	SHEET 386 OF 546

19+460
 R.W. LT 9.58
 R PHI DESIGN 1.25
 R.W. RT 12.53
 DESIGN 1.25
 R PHI DESIGN .9

11
 12 x 14 x 27

440 = 6.0
 603 = 7.8
 660 = 10.0
 660 = 10.0

US 7