
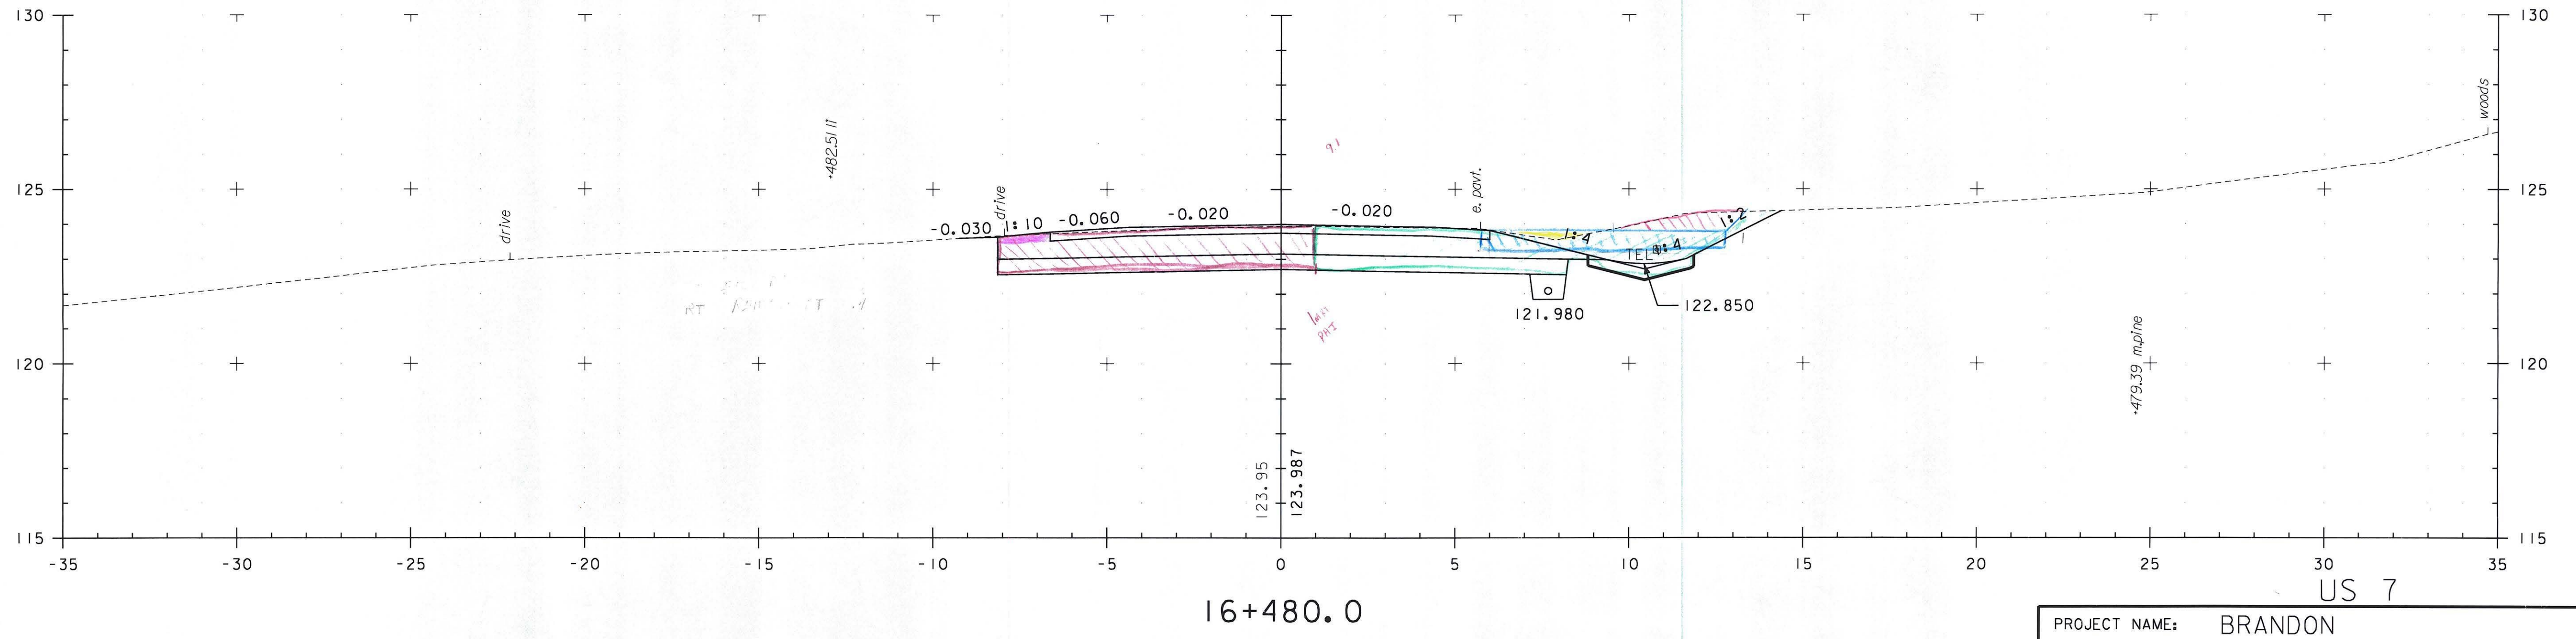


\* Pipe B-1-a = F = 8.46  
 B = 1.9m  
 C = 1.9m  
 D = 1.9m  
 E = 1.9m  
 110.79 cm (56) + 2.05 = 112.84

\* Pipe B-1-a = F = 8.46  
 B = 1.9m  
 C = 1.9m  
 D = 1.9m  
 E = 1.9m  
 19.08 (56) + 1.25 = 20.33

\* Headwall @ 15+20.5 (IT=A) 5.05m \* 1.5 = 7.575m  
 Pipe 15+20.5 (IT=A) 5.05m \* 3.1m (width) \* 1.1m (depth) = 16.88 cm  
 = (C) 2.05m (long) \* 14.7m (width) \* 1.0m (depth) = 30.26 cm  
 Structure @ 16+45 RT=(D) 9T 1.6m \* 2.1m (depth) = 16.88 cm  
 (E) 9T 1.1m \* 0.5m (depth) = 1.90 cm  
 Pipe B-1-a = (F) 1.9m (width) \* 2.7m (width) \* 1.65m (depth) = 8.46 cm  
 (G) 1.9m (width) \* 2.7m (width) \* 0.7m (depth) = 3.19 cm  
 Headwall @ 15+20.5 (IT=A) 4.5m (width) \* 1.5m (width) \* 1.1m (depth) = 7.43 cm

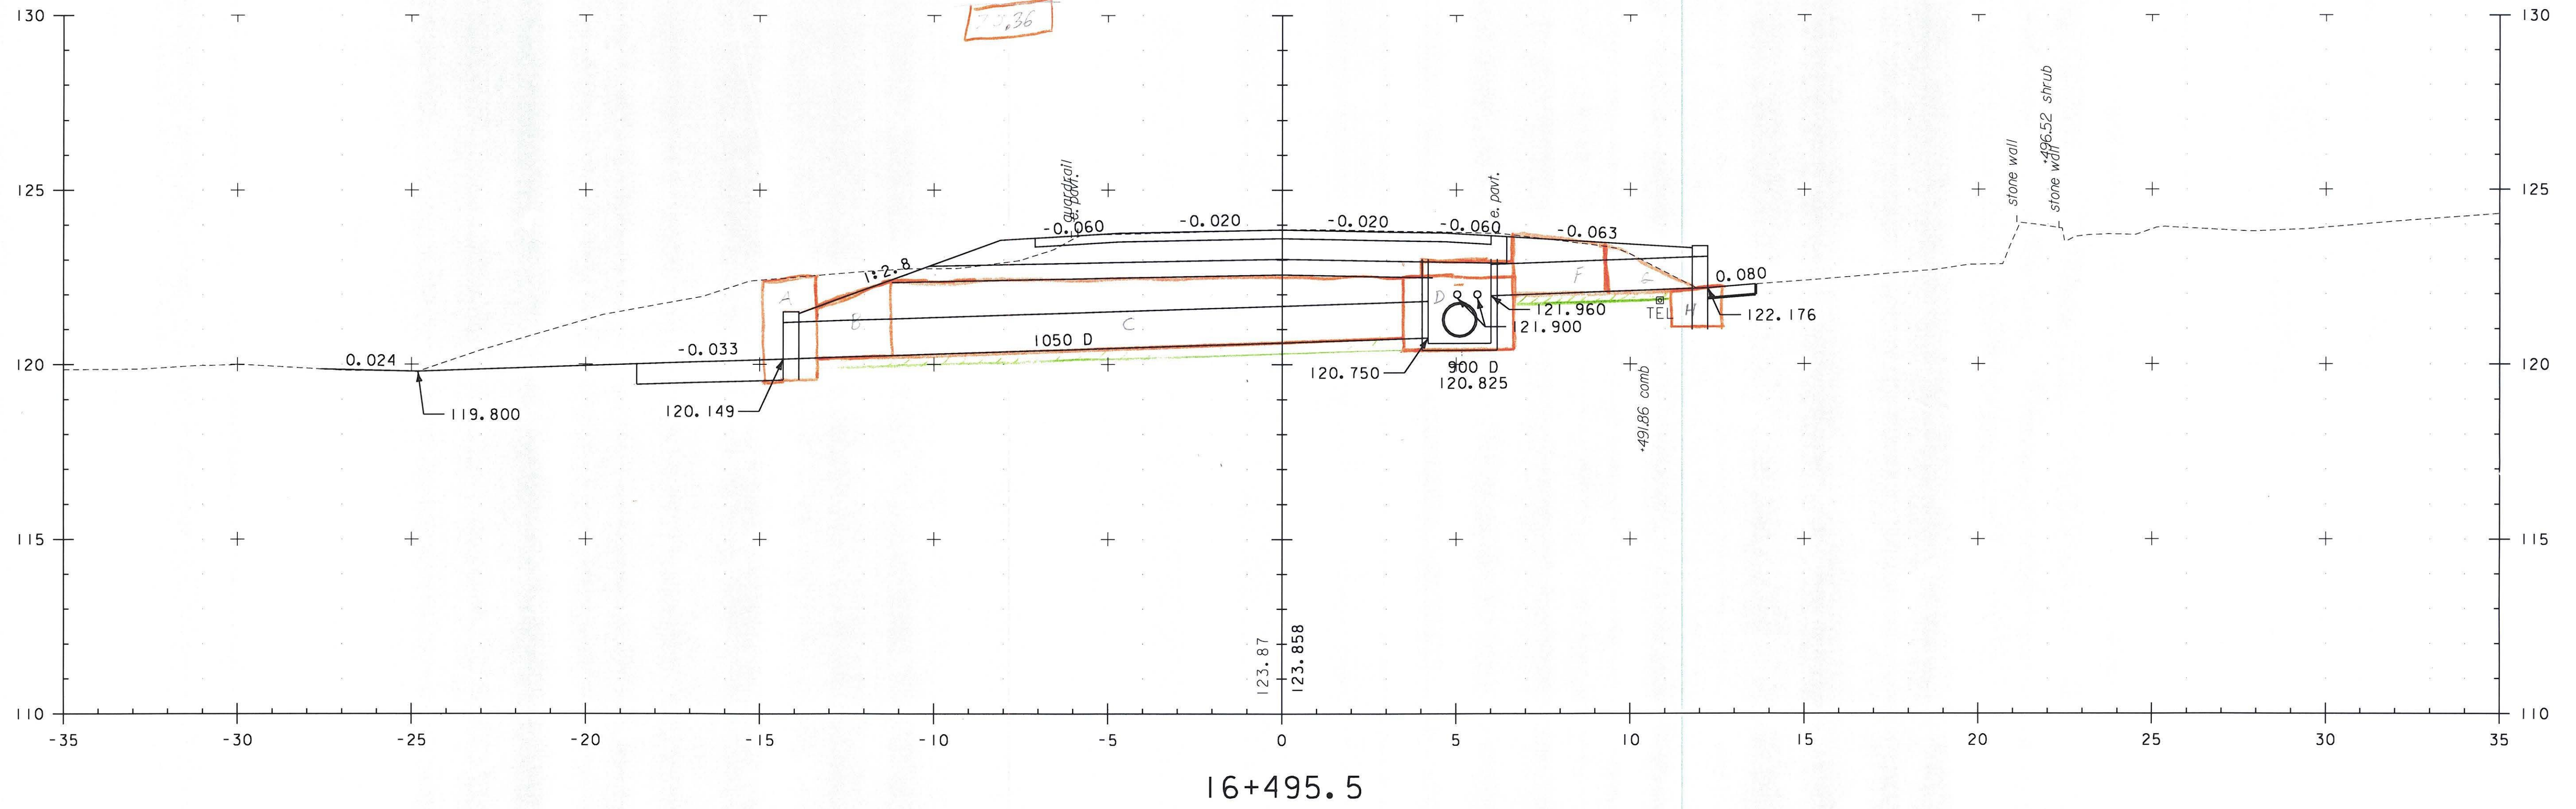

PROJECT NAME:	BRANDON	FILE NAME:	zb008s5-xs006.dgn	PLOT DATE:	9/
PROJECT NUMBER:	NH 019-3(495)	PROJECT LEADER:	CRB	DRAWN BY:	NL
		DESIGNED BY:	PTS	CHECKED BY:	DA
		CLD 02-0149		SHEET	387

