


US 7

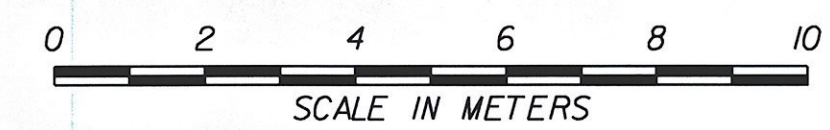

PROJECT NAME: BRANDON
PROJECT NUMBER: NH 019-3(495)

FILE NAME: zb008s5-xs01.dgn
PROJECT LEADER: CRB
DESIGNED BY: PTS
CLD 02-049

PLOT DATE: 9/3/2009
DRAWN BY: NLL
CHECKED BY: DAM
SHEET 392 OF 546