



16+880.0

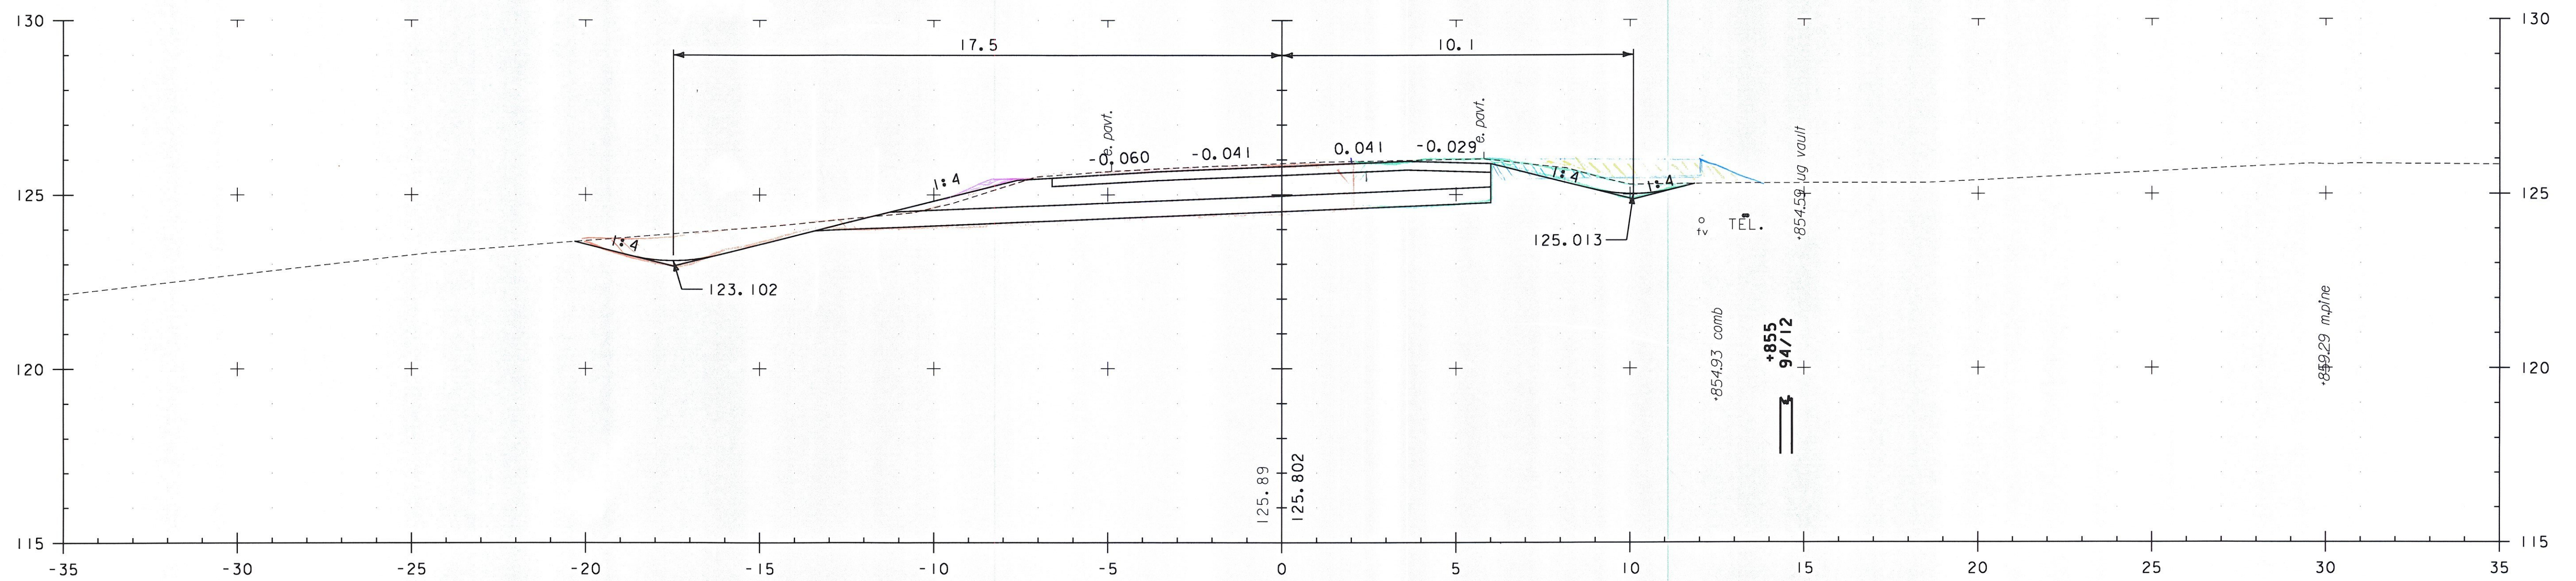

16+860.0

US 7

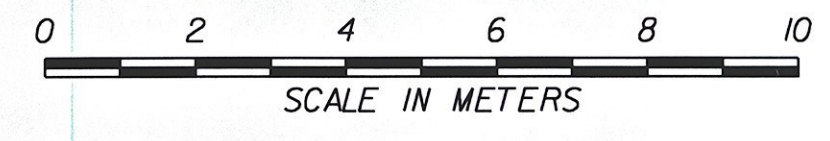

| | | | |
|-----------------|-------------------|-----------------|------------|
| PROJECT NAME: | BRANDON | | |
| PROJECT NUMBER: | NH 019-3(495) | | |
| FILE NAME: | zb008s5-xs019.dgn | PROJECT LEADER: | CRB |
| DESIGNED BY: | PTS | CHECKED BY: | DAM |
| CLD 02-0149 | | PLOT DATE: | 9/3/2009 |
| | | DRAWN BY: | NLL |
| | | CHECKED BY: | DAM |
| | | SHEET | 400 OF 546 |