



17+040.0

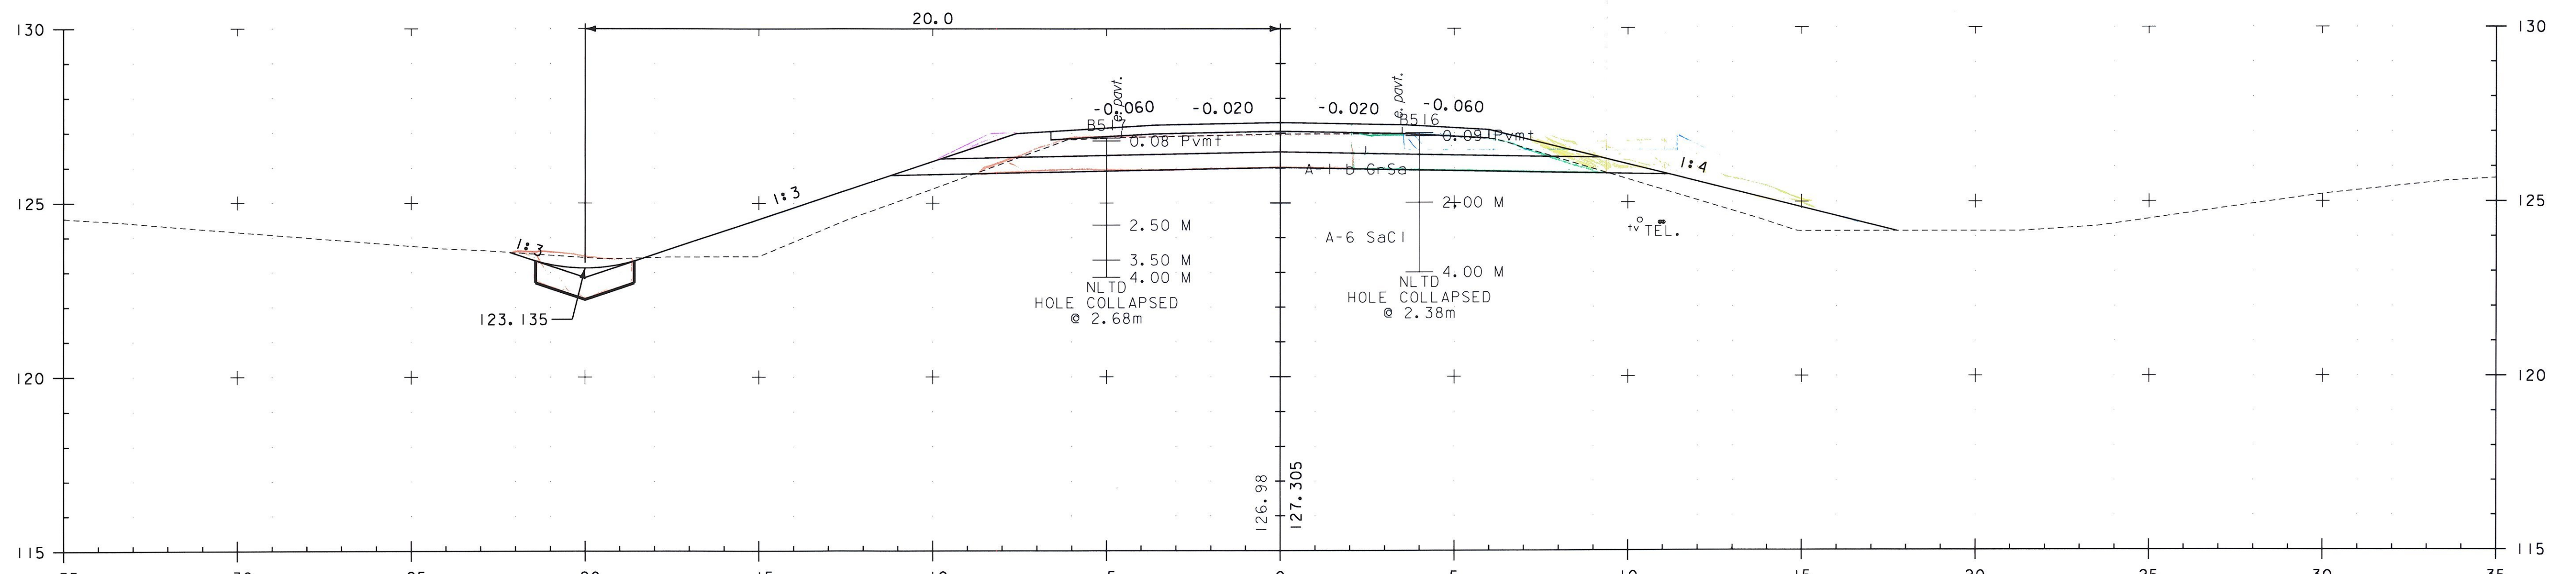

17+020.0

US 7

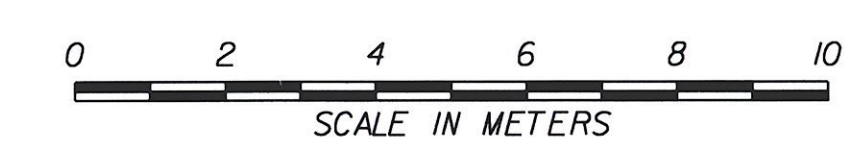

PROJECT NAME:	BRANDON	FILE NAME:	zb008s5-xs024.dgn	PLOT DATE:	9/3/2009
PROJECT NUMBER:	NH 019-3(495)	PROJECT LEADER:	CRB	DRAWN BY:	NLL
DESIGNED BY:	PTS	CHECKED BY:	DAM		
CLD 02-0149		SHEET	405	OF	546