




DATE
BY
SURVEYED
PLOTTED
NOTE BOOK
AREAS CHECKED
NO.

DATE
BY
ORIGINAL
SURVEY
PLOTTED
NOTE BOOK
AREAS CHECKED
NO.

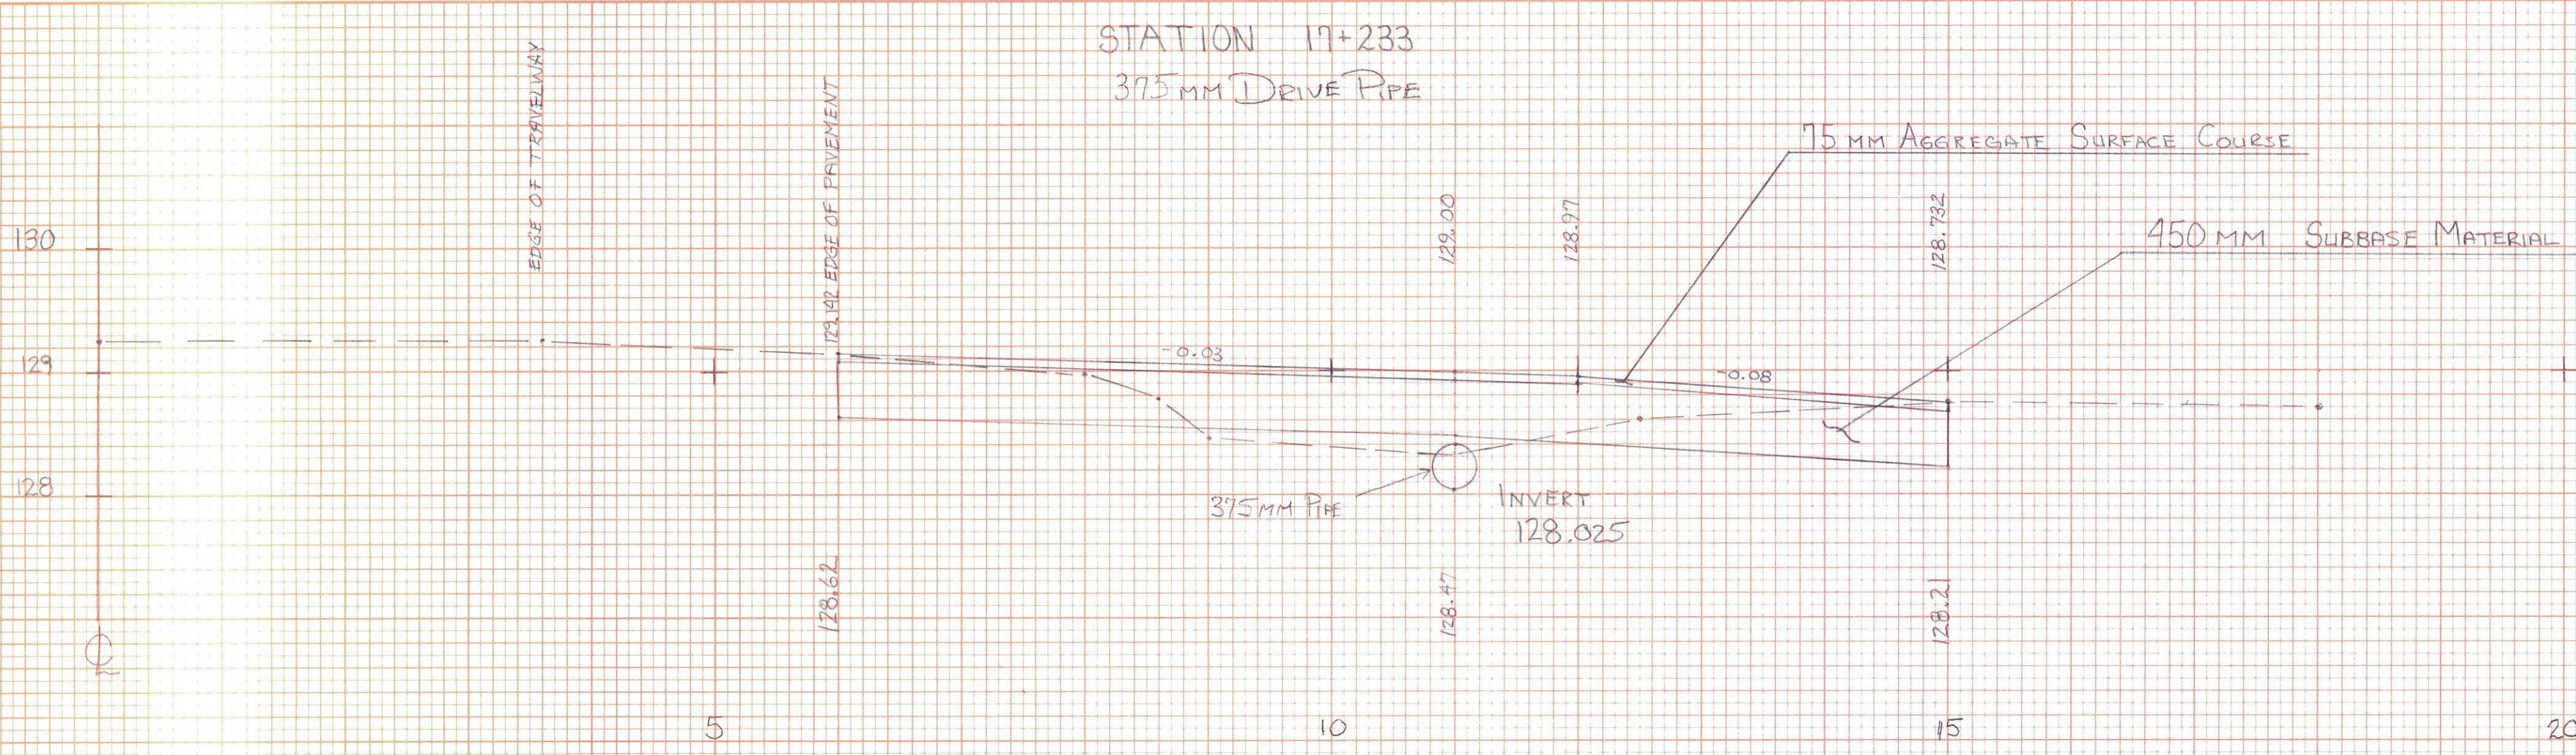

PIPE INVERT @ 11 M RT

129.000	24" COVER (3" AGGREGATE SURFACE, 18" SUBBASE, 3" OTHER)
- 0.600	
- 0.375	
128.025	

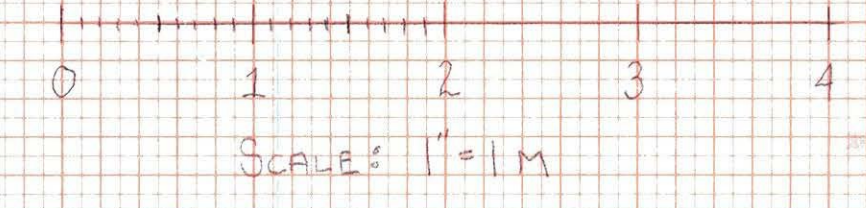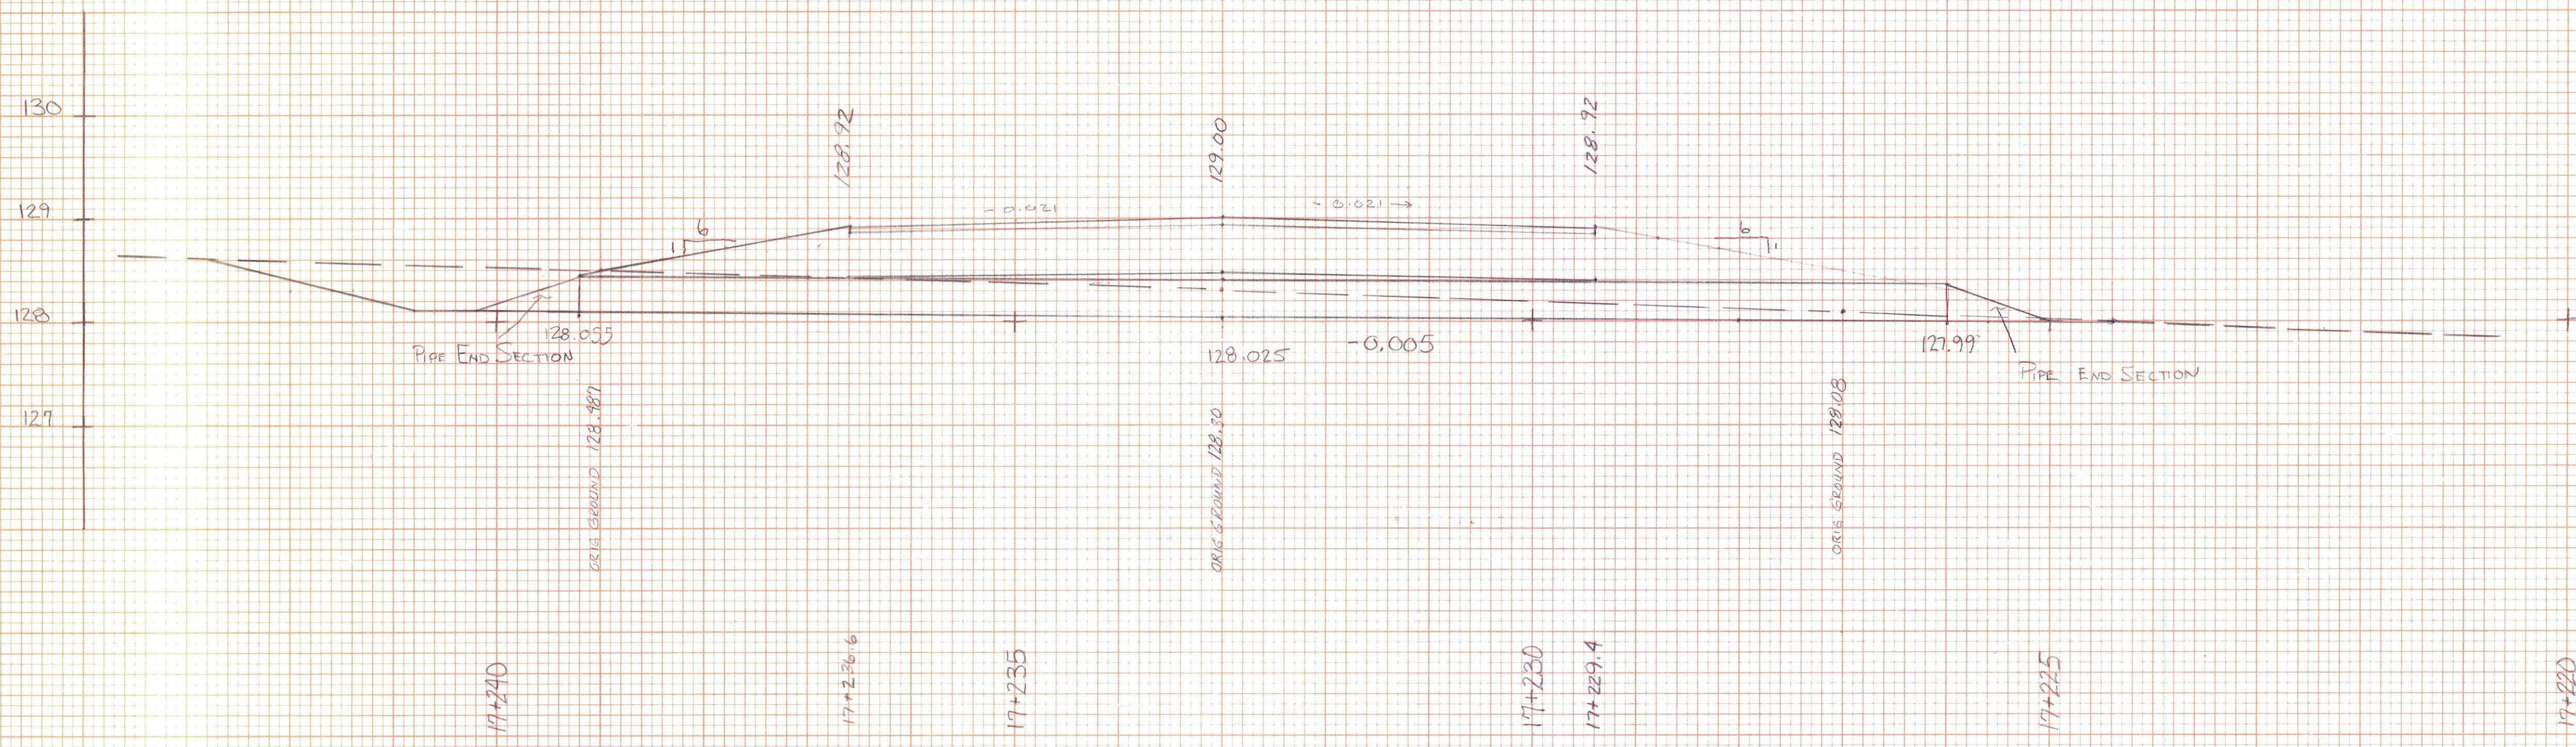

BRANDON NH 019-3(495)
G-STONE MOTORS DRIVE
STATION 17+233
SHEET 405B
BY: TIMOTHY POKETTE 07-25-11