


US 7

PROJECT NAME: BRANDON
 PROJECT NUMBER: NH 019-3(495)

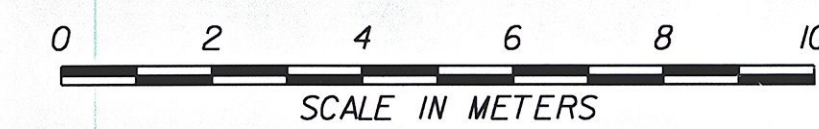

FILE NAME: zb008s5-xs026.dgn	PLOT DATE: 9/3/2009
PROJECT LEADER: CRB	DRAWN BY: NLL
DESIGNED BY: PTS	CHECKED BY: DAM
CLD 02-0149	SHEET 407 OF 546