




17+120.0

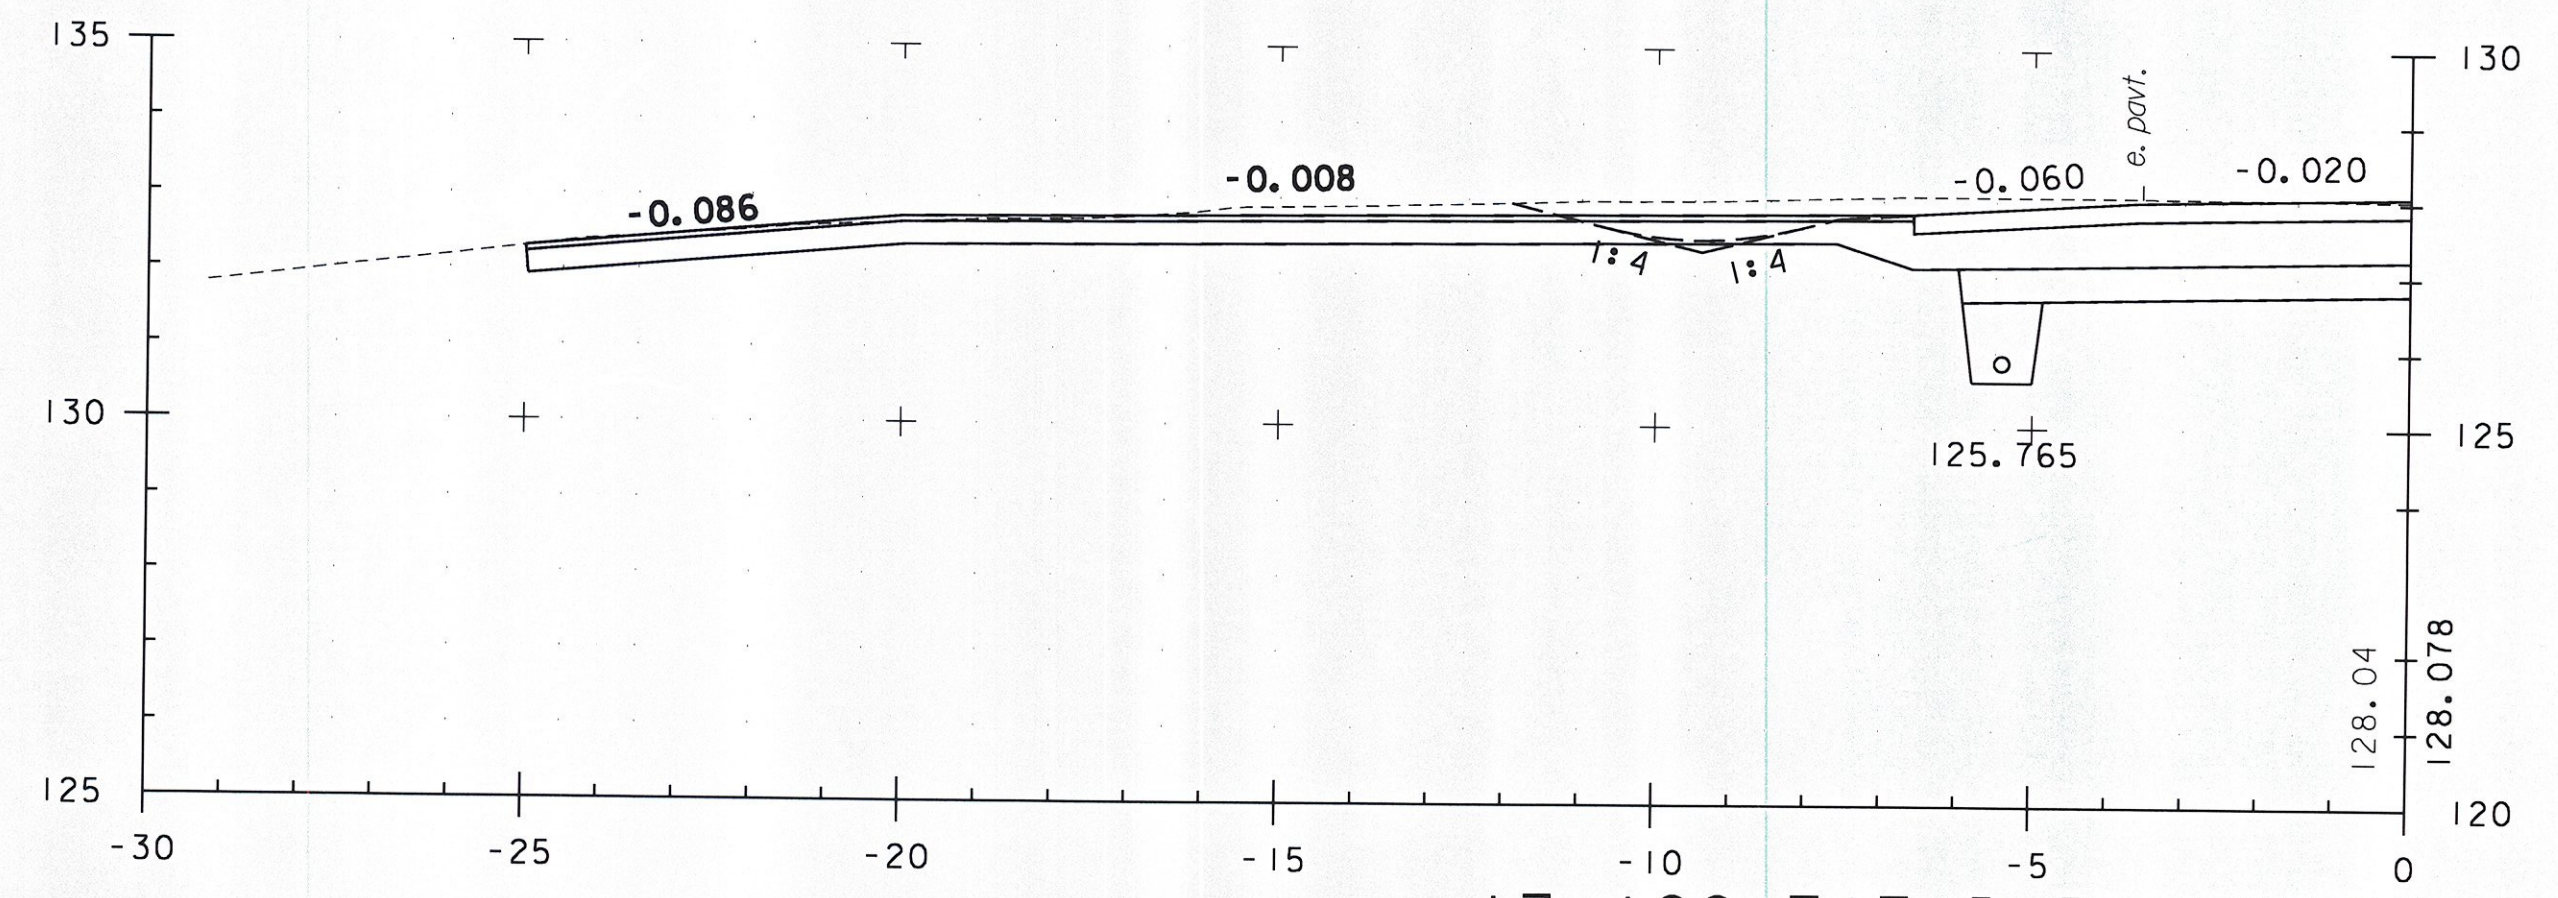

17+100 FIELD DR NORTH

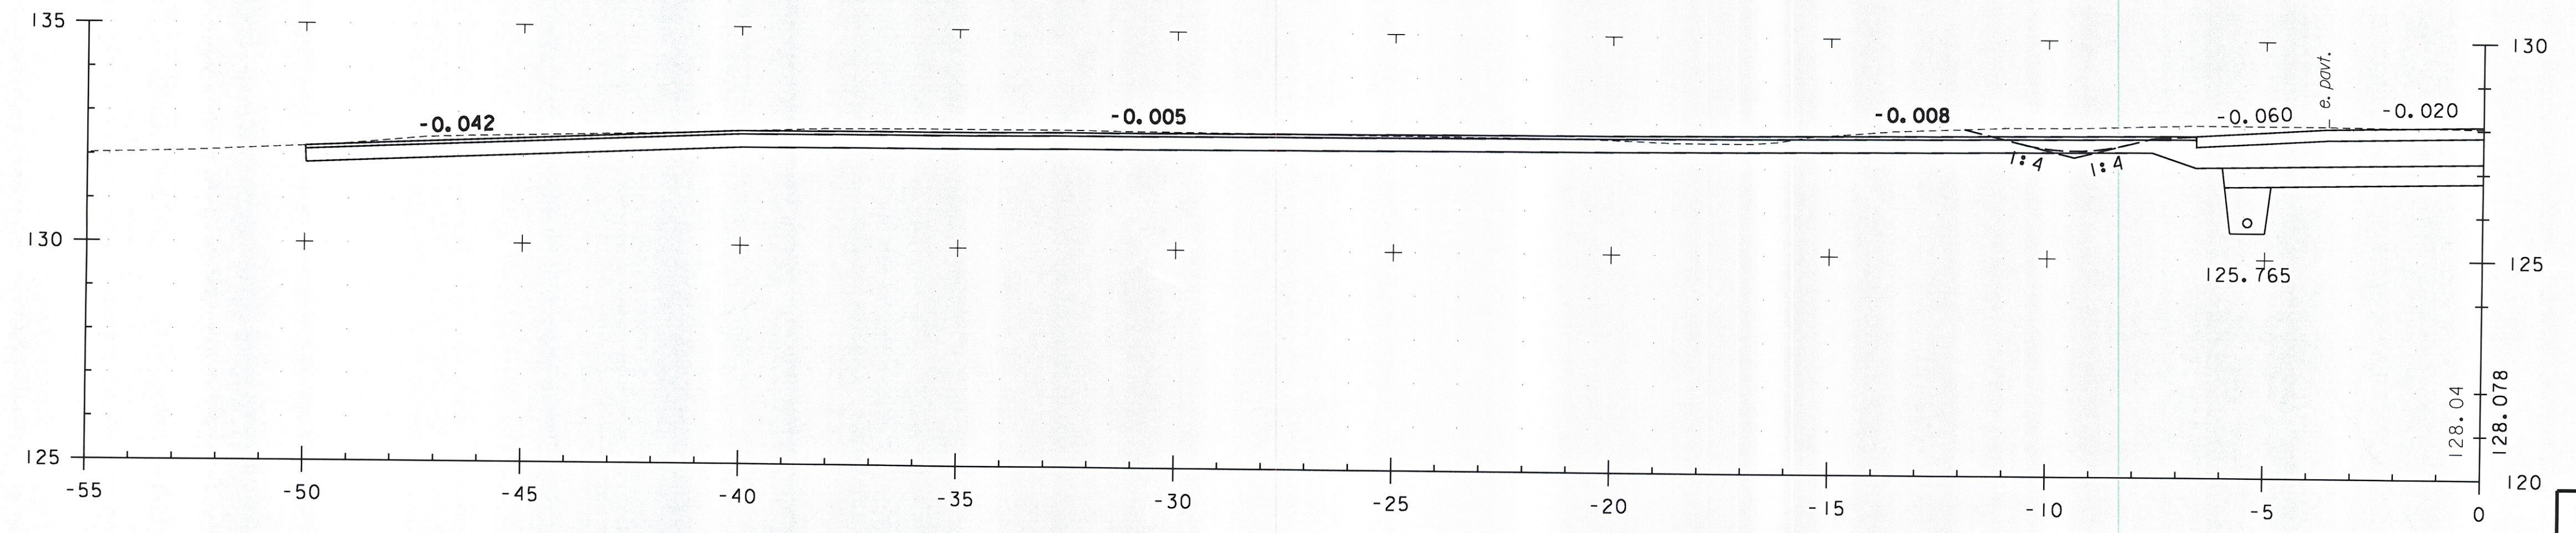

17+100 FIELD DR SOUTH

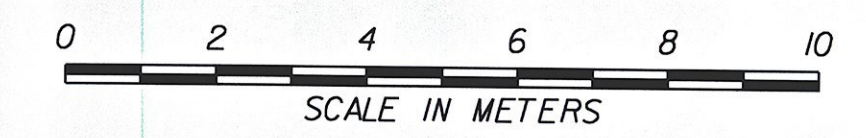

US 7	
PROJECT NAME:	BRANDON
PROJECT NUMBER:	NH 019-3(495)
FILE NAME:	zb008s5-xs027.dgn
PROJECT LEADER:	CRB
DESIGNED BY:	PTS
CLD 02-0149	
PLOT DATE:	9/3/2009
DRAWN BY:	NLL
CHECKED BY:	DAM
SHEET	408 OF 546