



17+400.0

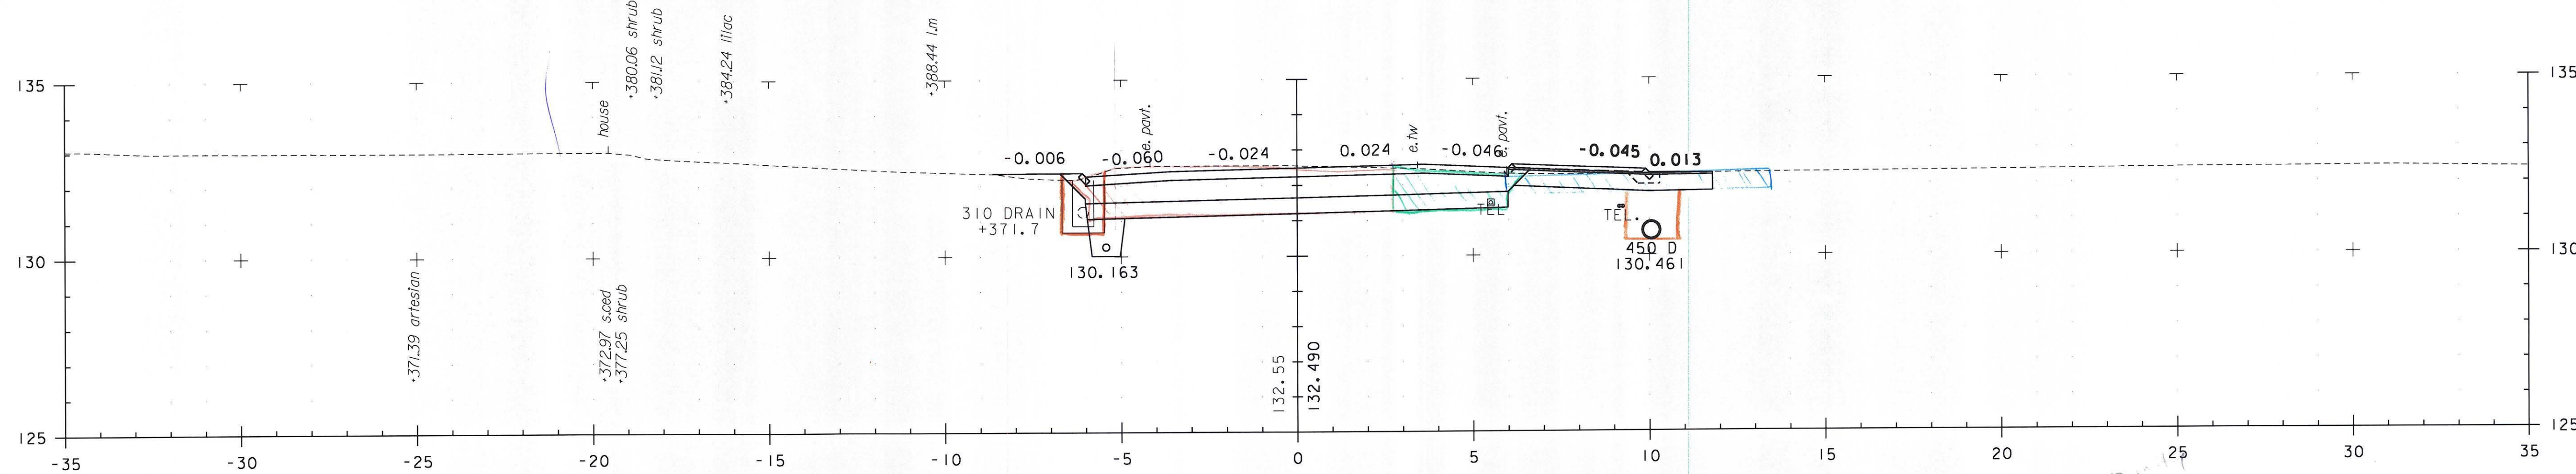

17+380.0
DRIVE RT

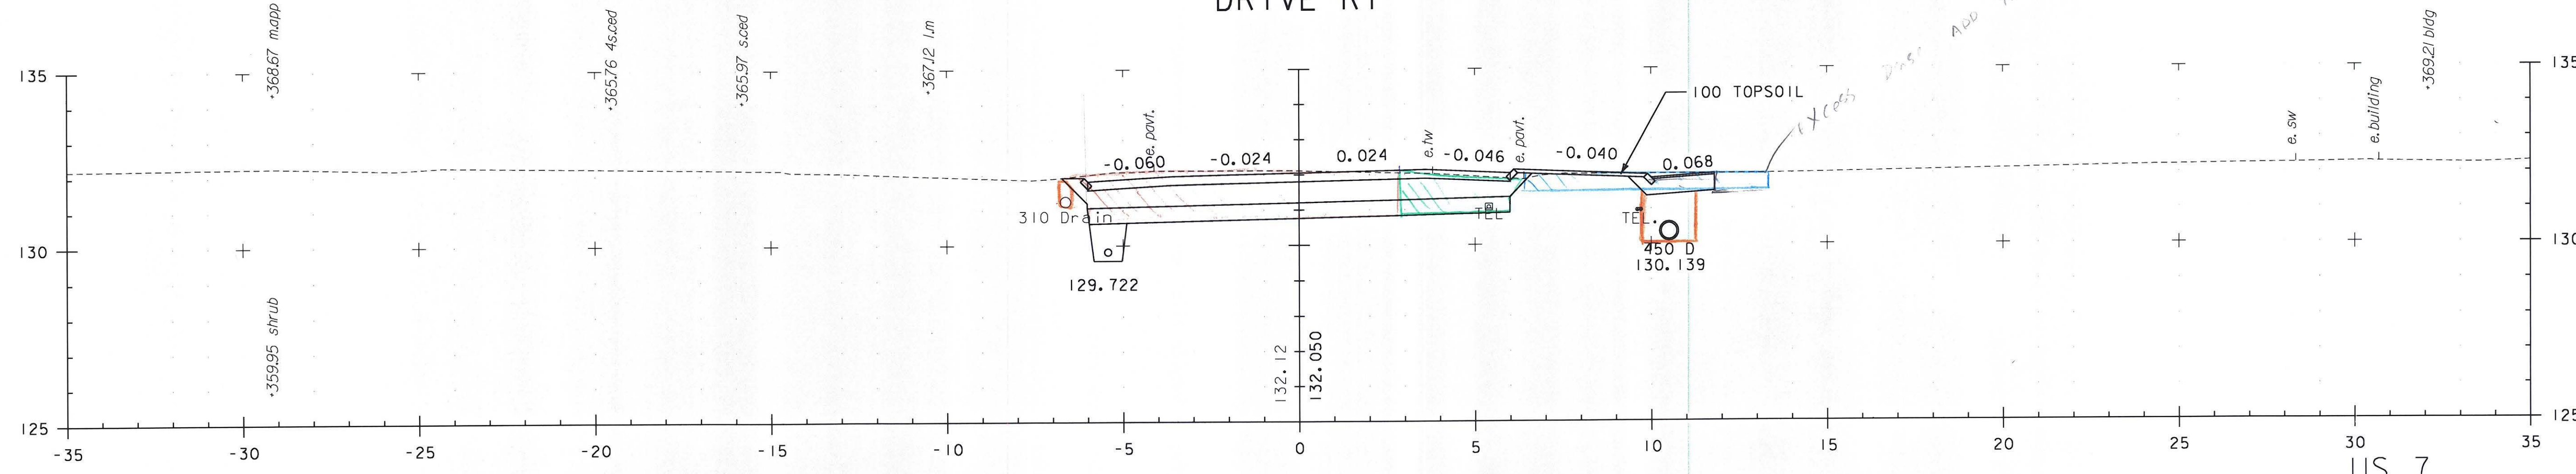

17+360.0

US 7

PROJECT NAME:	BRANDON
PROJECT NUMBER:	NH 019-3(495)
FILE NAME:	zb008s5-xs035.dgn
PROJECT LEADER:	CRB
DESIGNED BY:	PTS
CLD 02-0149	
PLOT DATE:	9/3/2009
DRAWN BY:	NLL
CHECKED BY:	DAM
SHEET	416 OF 546

