


17+815.0

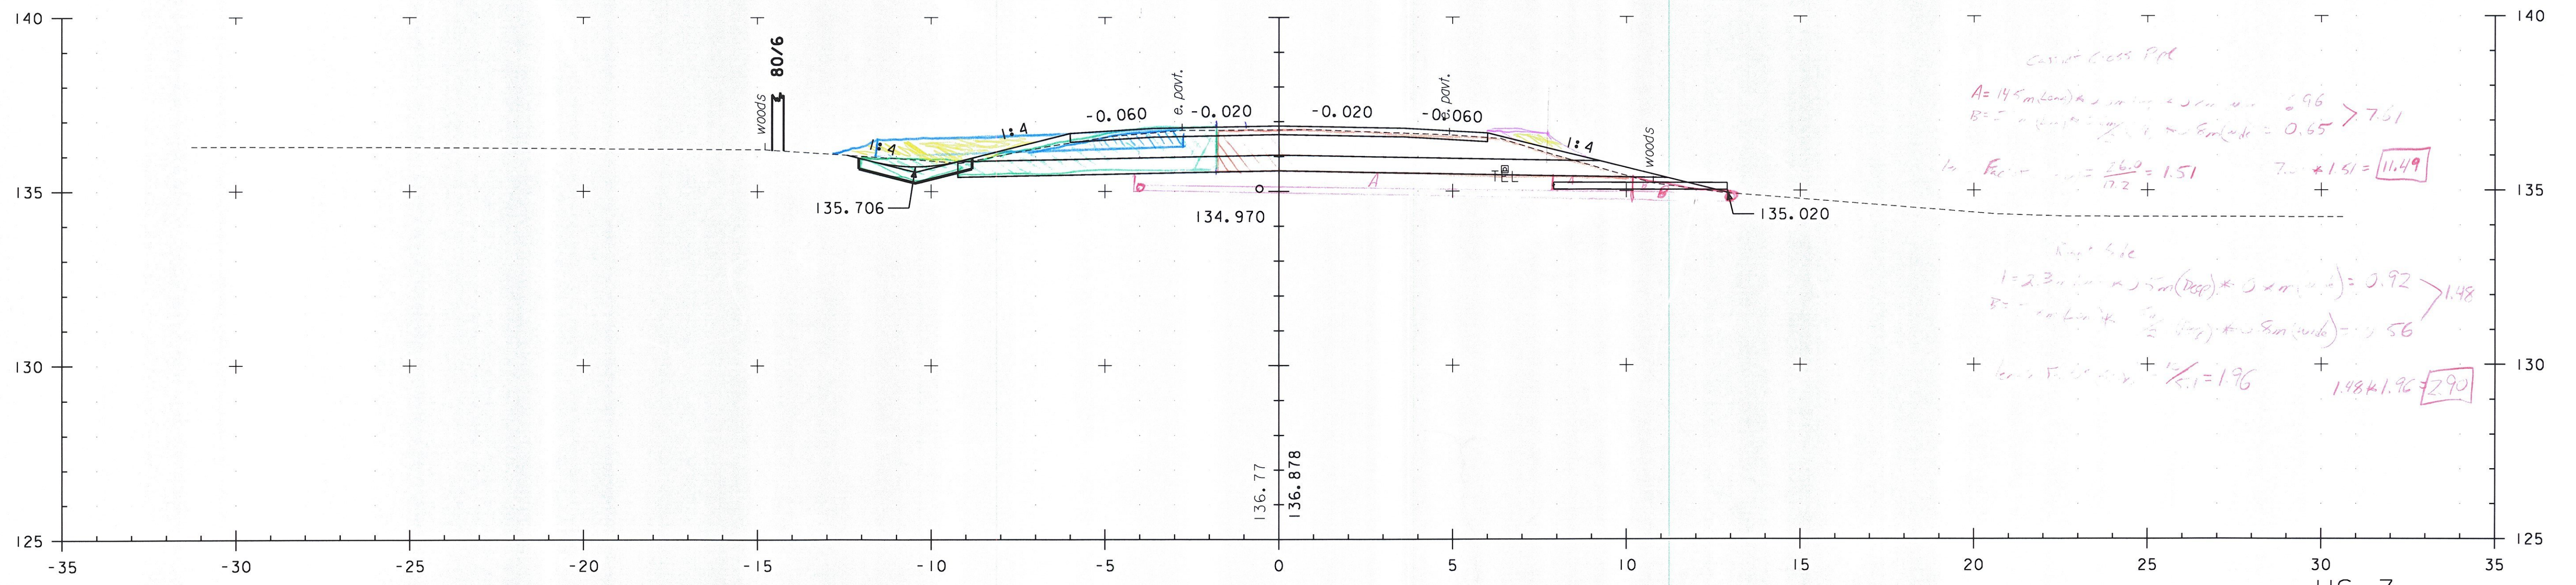

17+800.0

Handwritten calculations:

$A = 14.5 \text{ (m)} \times 2 \times 0.65 = 18.9$
 $B = 5 \text{ (m)} \times 2 \times 0.65 = 6.5$
 $\text{Total Area} = 18.9 + 6.5 = 25.4$
 $25.4 \times 1.51 = 38.354$
 $38.354 \times 1.96 = 75.18$

$A = 2.3 \text{ (m)} \times 2 \times 0.65 = 2.99$
 $B = 1 \text{ (m)} \times 2 \times 0.65 = 1.3$
 $\text{Total Area} = 2.99 + 1.3 = 4.29$
 $4.29 \times 1.51 = 6.4779$
 $6.4779 \times 1.96 = 12.7$

US 7

PROJECT NAME: BRANDON	PLOT DATE: 9/3/2009
PROJECT NUMBER: NH 019-3(495)	DRAWN BY: NLL
FILE NAME: zb008s5-xs048.dgn	CHECKED BY: DAM
PROJECT LEADER: CRB	SHEET 429 OF 546
DESIGNED BY: PTS	
CLD 02-0149	

