



17+868.0  
DRIVE RT

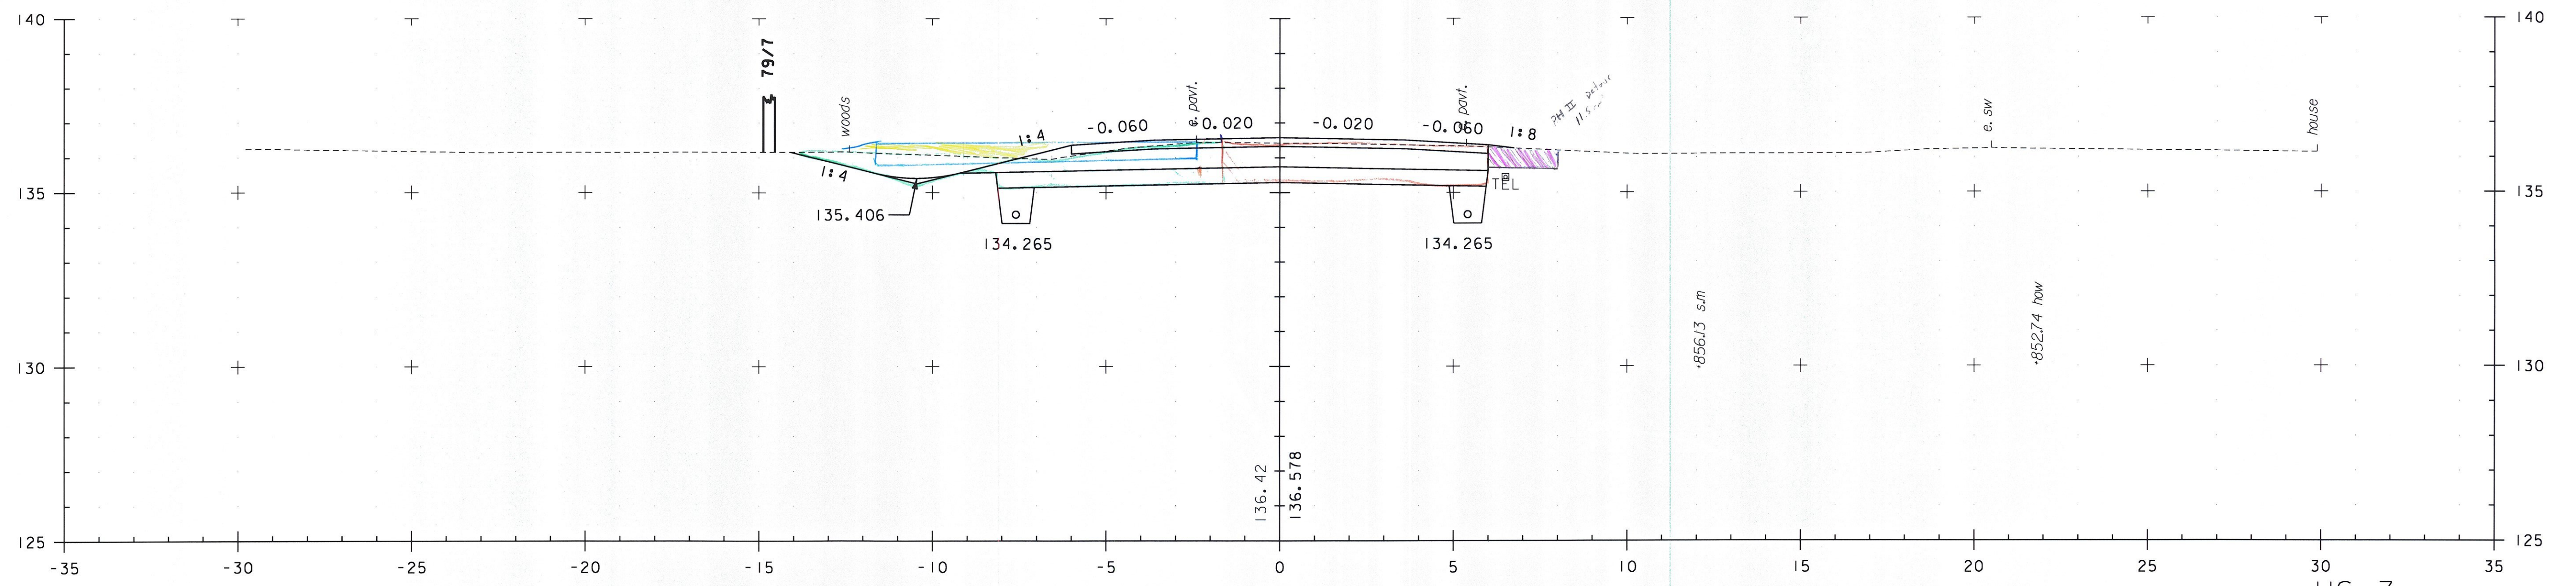

17+860.0  
US 7

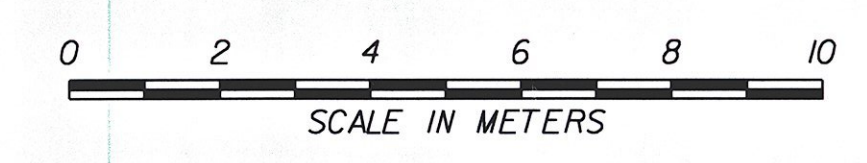

PROJECT NAME: BRANDON	PLOT DATE: 9/3/2009
PROJECT NUMBER: NH 019-3(495)	DRAWN BY: NLL
FILE NAME: zb008s5-xs050.dgn	CHECKED BY: DAM
PROJECT LEADER: CRB	SHEET 431 OF 546
DESIGNED BY: PTS	
CLD 02-0149	