



18+017.0
DRIVE RT

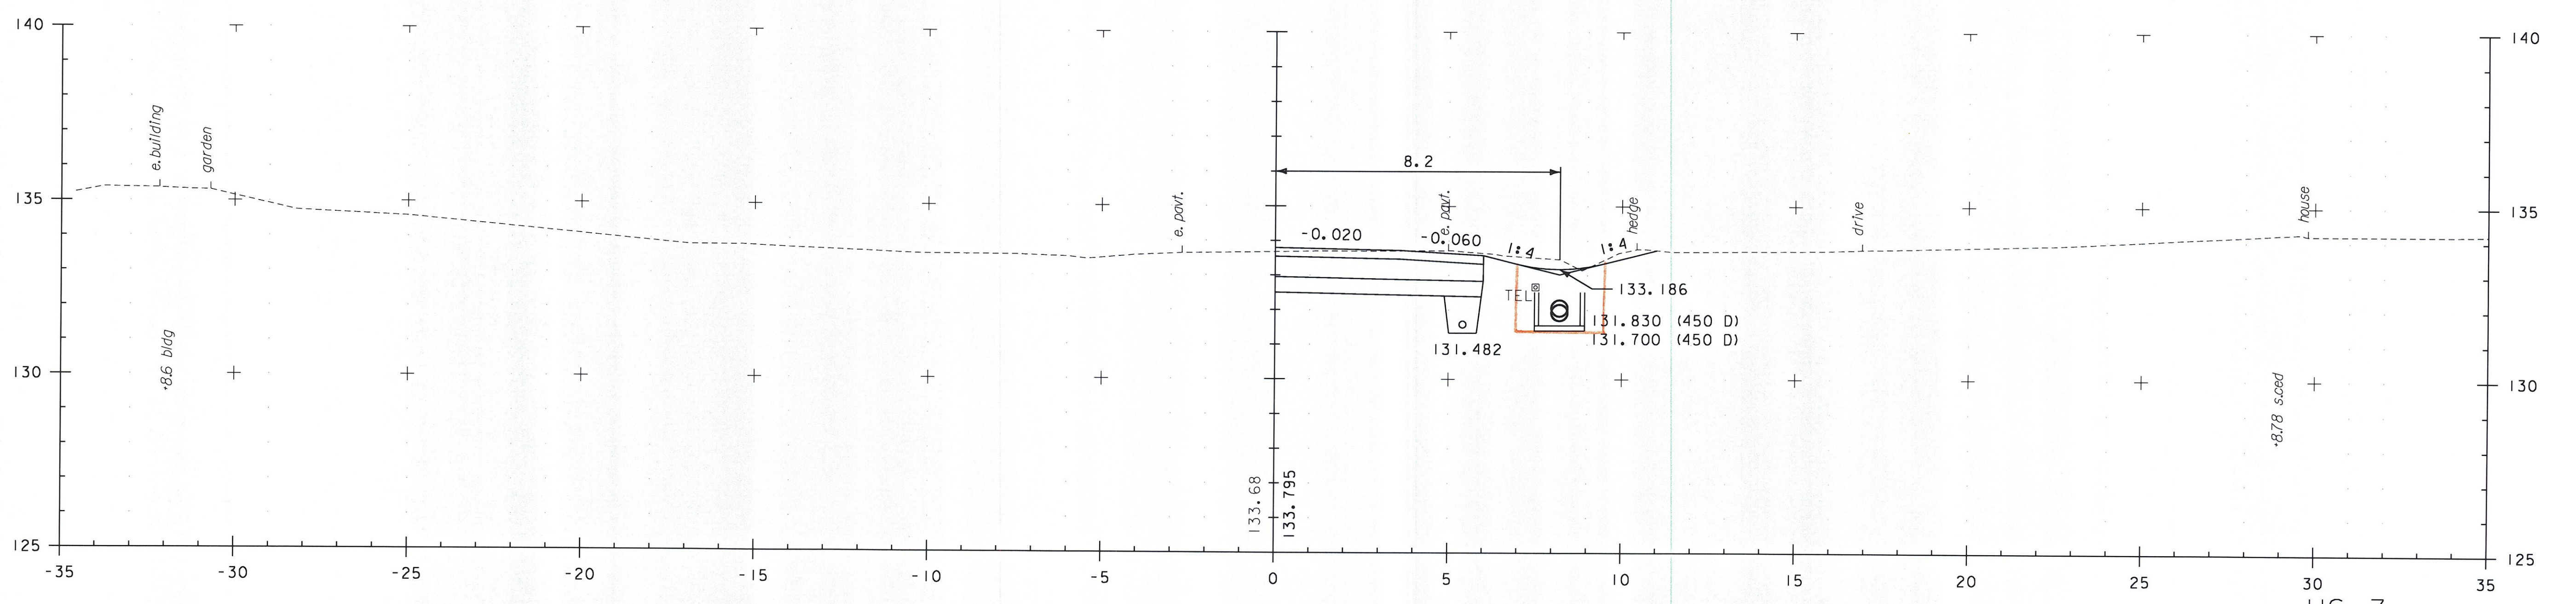

18+012.0

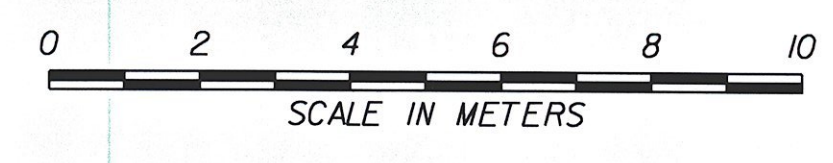

PROJECT NAME:	BRANDON	PLOT DATE:	9/3/2009
PROJECT NUMBER:	NH 019-3(495)	DRAWN BY:	NLL
FILE NAME:	zb008s5-xs056.dgn	CHECKED BY:	DAM
PROJECT LEADER:	CRB	SHEET	437 OF 546
DESIGNED BY:	PTS		
CLD	02-0149		