


18+100.0

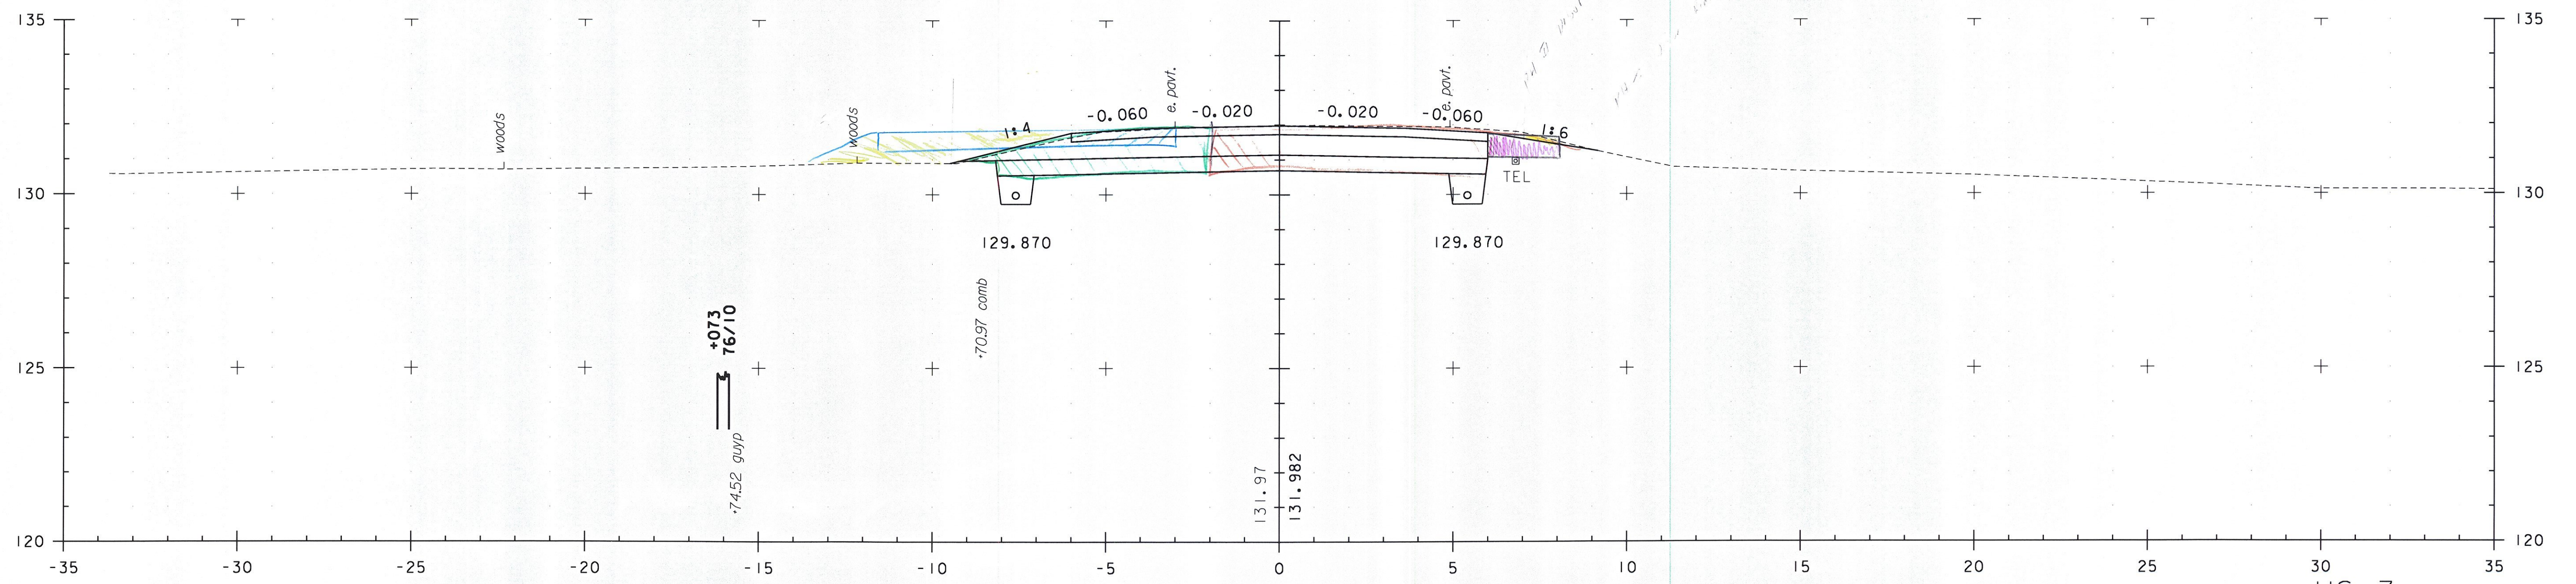

18+080.0

US 7

PROJECT NAME: BRANDON	PLOT DATE: 9/3/2009
PROJECT NUMBER: NH 019-3(495)	DRAWN BY: NLL
FILE NAME: zb008s5-xs059.dgn	CHECKED BY: DAM
PROJECT LEADER: CRB	SHEET 440 OF 546
DESIGNED BY: PTS	
CLD 02-0149	

