



DETAIL "A"

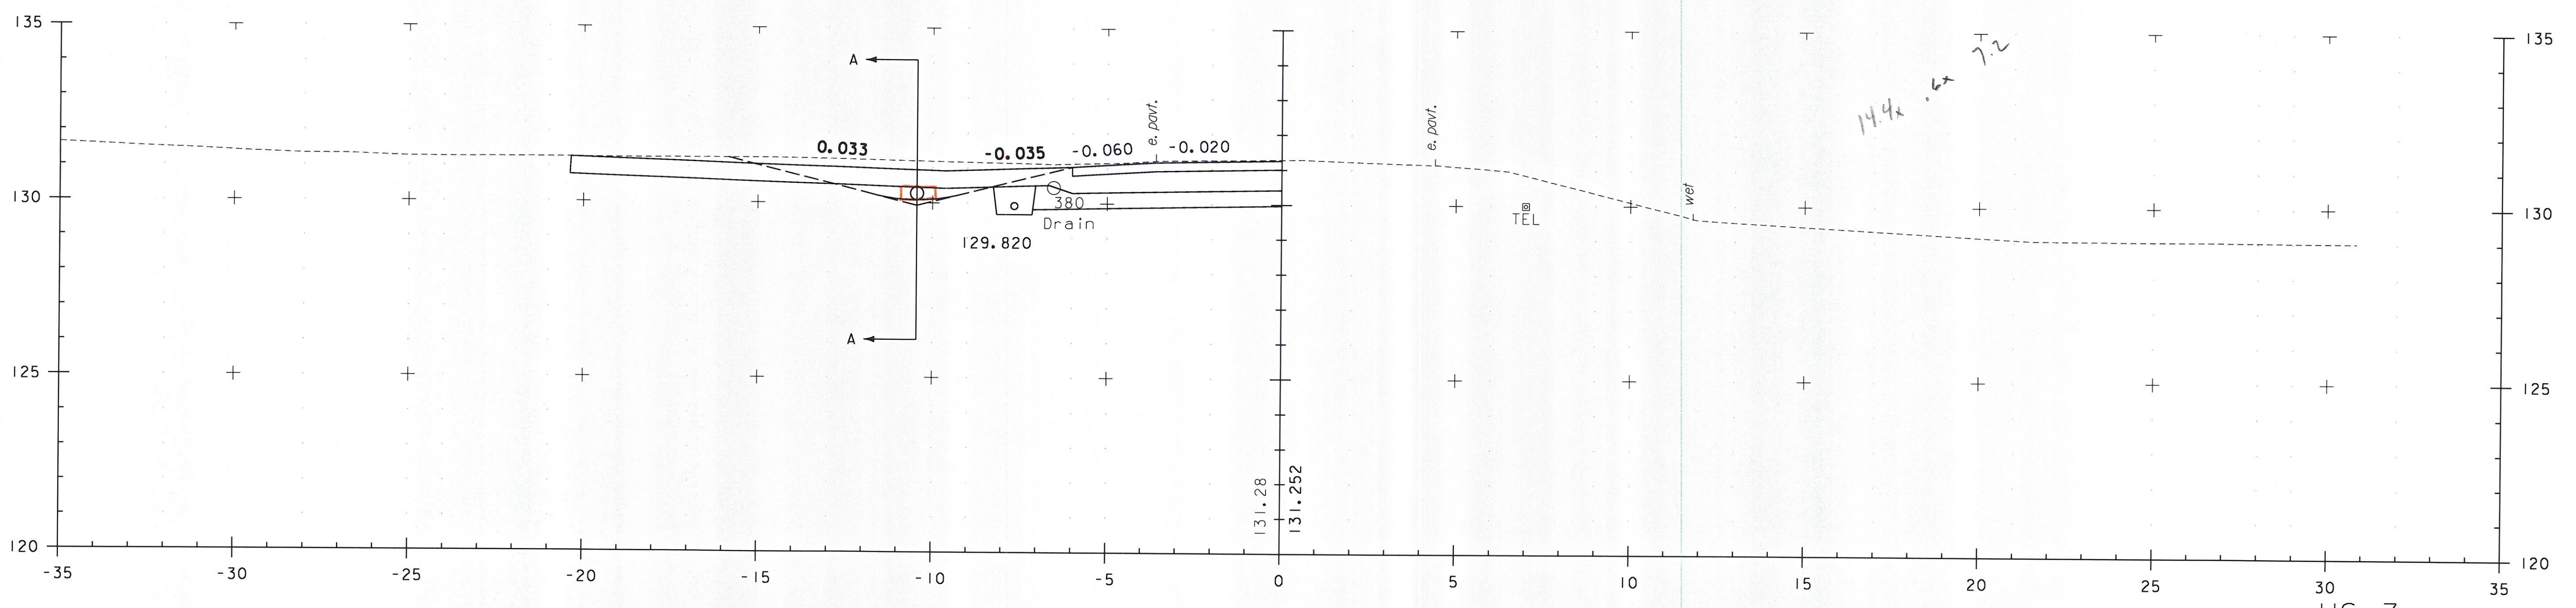

18+164.0
DRIVE LT

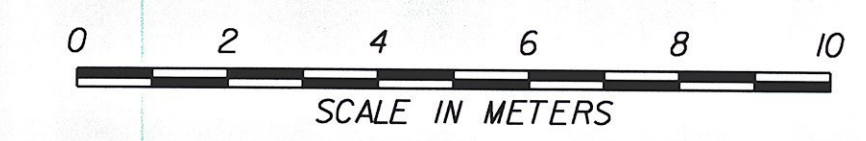

PROJECT NAME: BRANDON		PLOT DATE: 9/3/2009	
PROJECT NUMBER: NH 019-3(495)		DRAWN BY: NLL	
FILE NAME: zb008s5-xs062.dgn	DESIGNED BY: PTS	CHECKED BY: DAM	SHEET 443 OF 546

US 7