


18+291.0
DRIVE LT

US 7

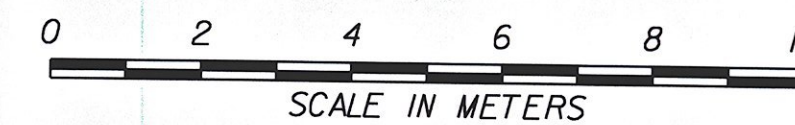

| | |
|-------------------------------|---------------------|
| PROJECT NAME: BRANDON | PLOT DATE: 9/3/2009 |
| PROJECT NUMBER: NH 019-3(495) | DRAWN BY: NLL |
| FILE NAME: zb008s5-xs066.dgn | CHECKED BY: DAM |
| PROJECT LEADER: CRB | SHEET 447 OF 546 |
| DESIGNED BY: PTS | |
| CLD 02-0149 | |