


1.008  
+ .774  
+ .158  
1.94

18+660.0

US 7

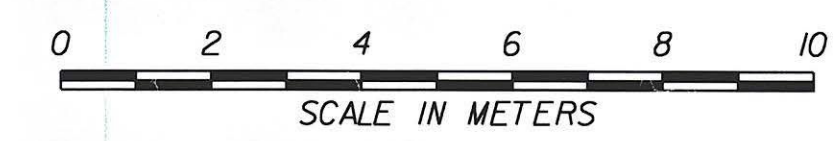

PROJECT NAME: BRANDON	PLOT DATE: 9/3/2009
PROJECT NUMBER: NH 019-3(495)	DRAWN BY: NLL
FILE NAME: zb008s5-xs080.dgn	CHECKED BY: DAM
DESIGNED BY: PTS	SHEET 461 OF 546
CLD 02-0149	