





14.3 x 3.6

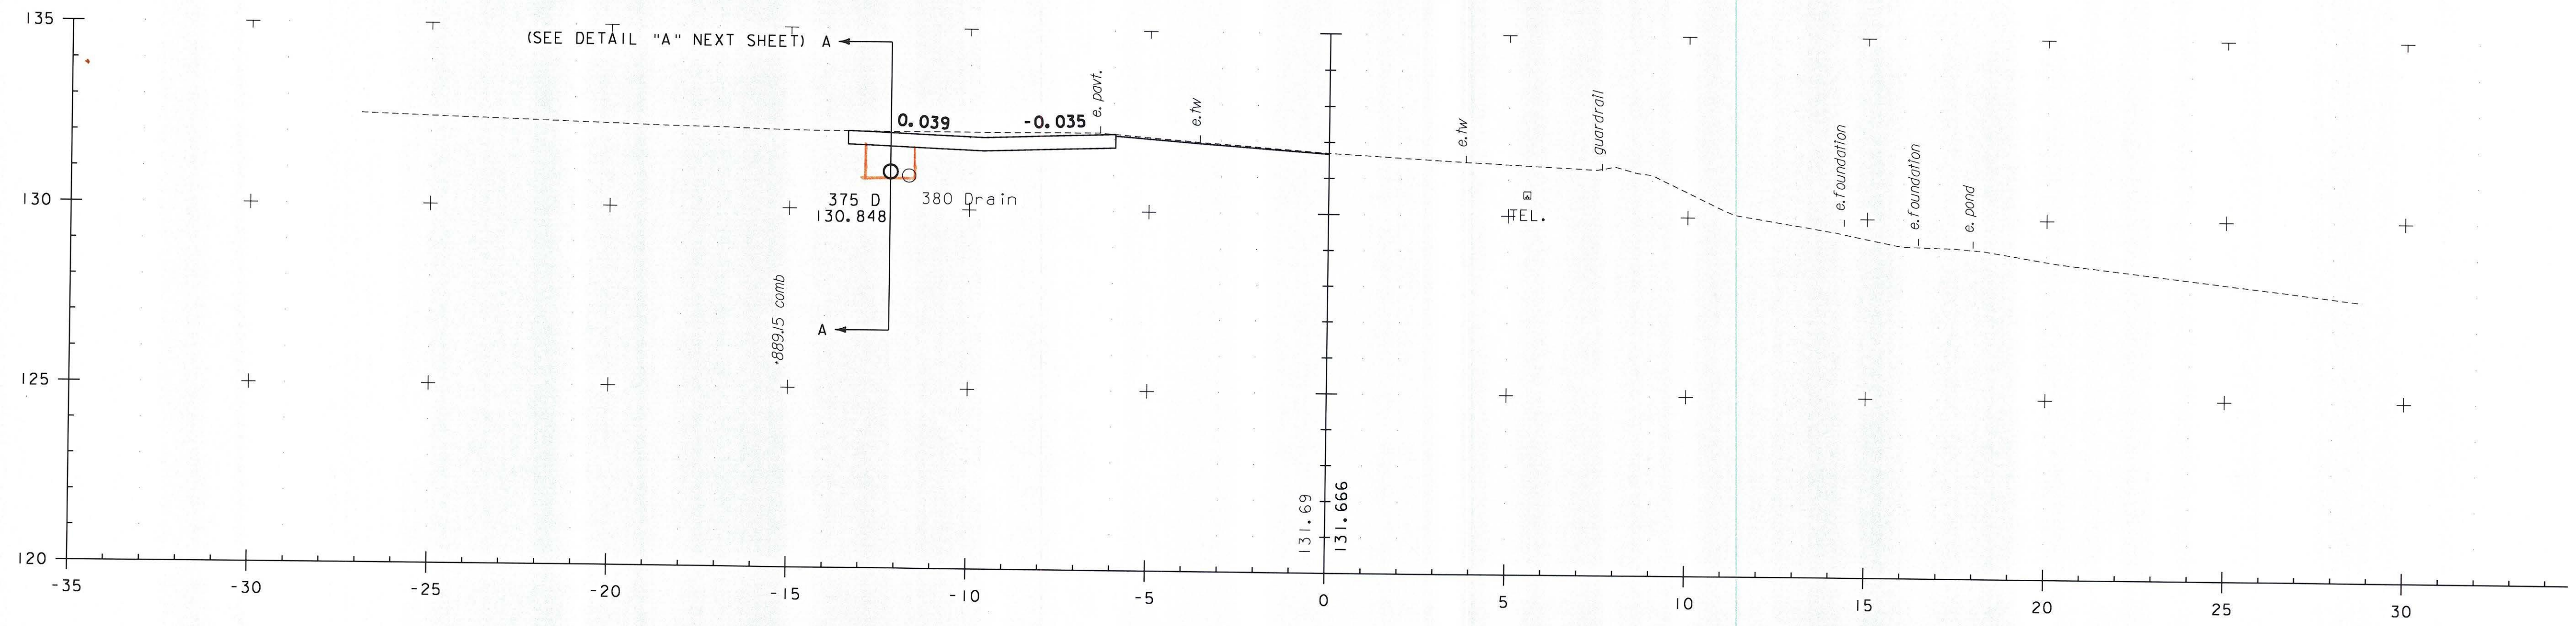


18+895.5  
DRIVE LT

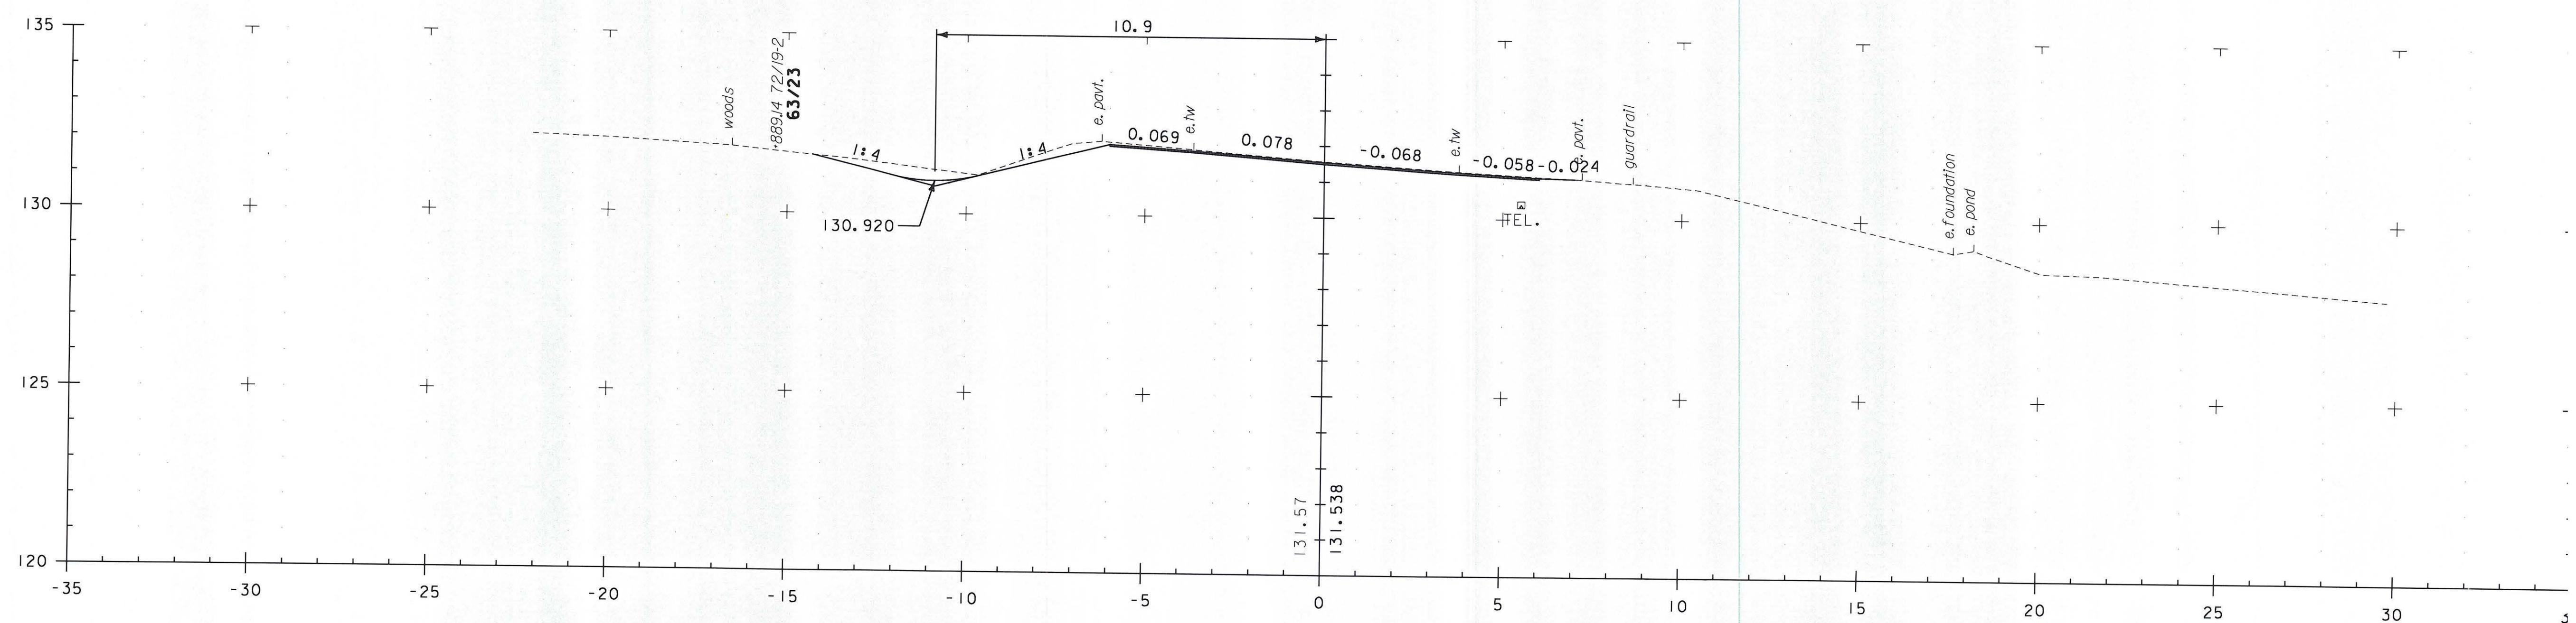

18+880.0

US 7

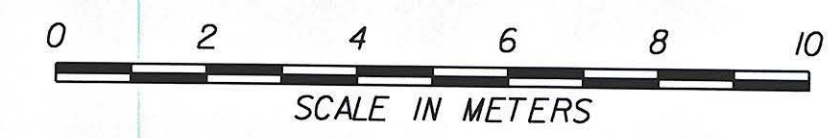

PROJECT NAME:	BRANDON	PLOT DA
PROJECT NUMBER:	NH 019-3(495)	DRAWN B
FILE NAME:	zb008s5-xs089.dgn	CHECKED
PROJECT LEADER:	CRB	SHEET
DESIGNED BY:	PTS	
CLD 02-0149		