



18+900.0

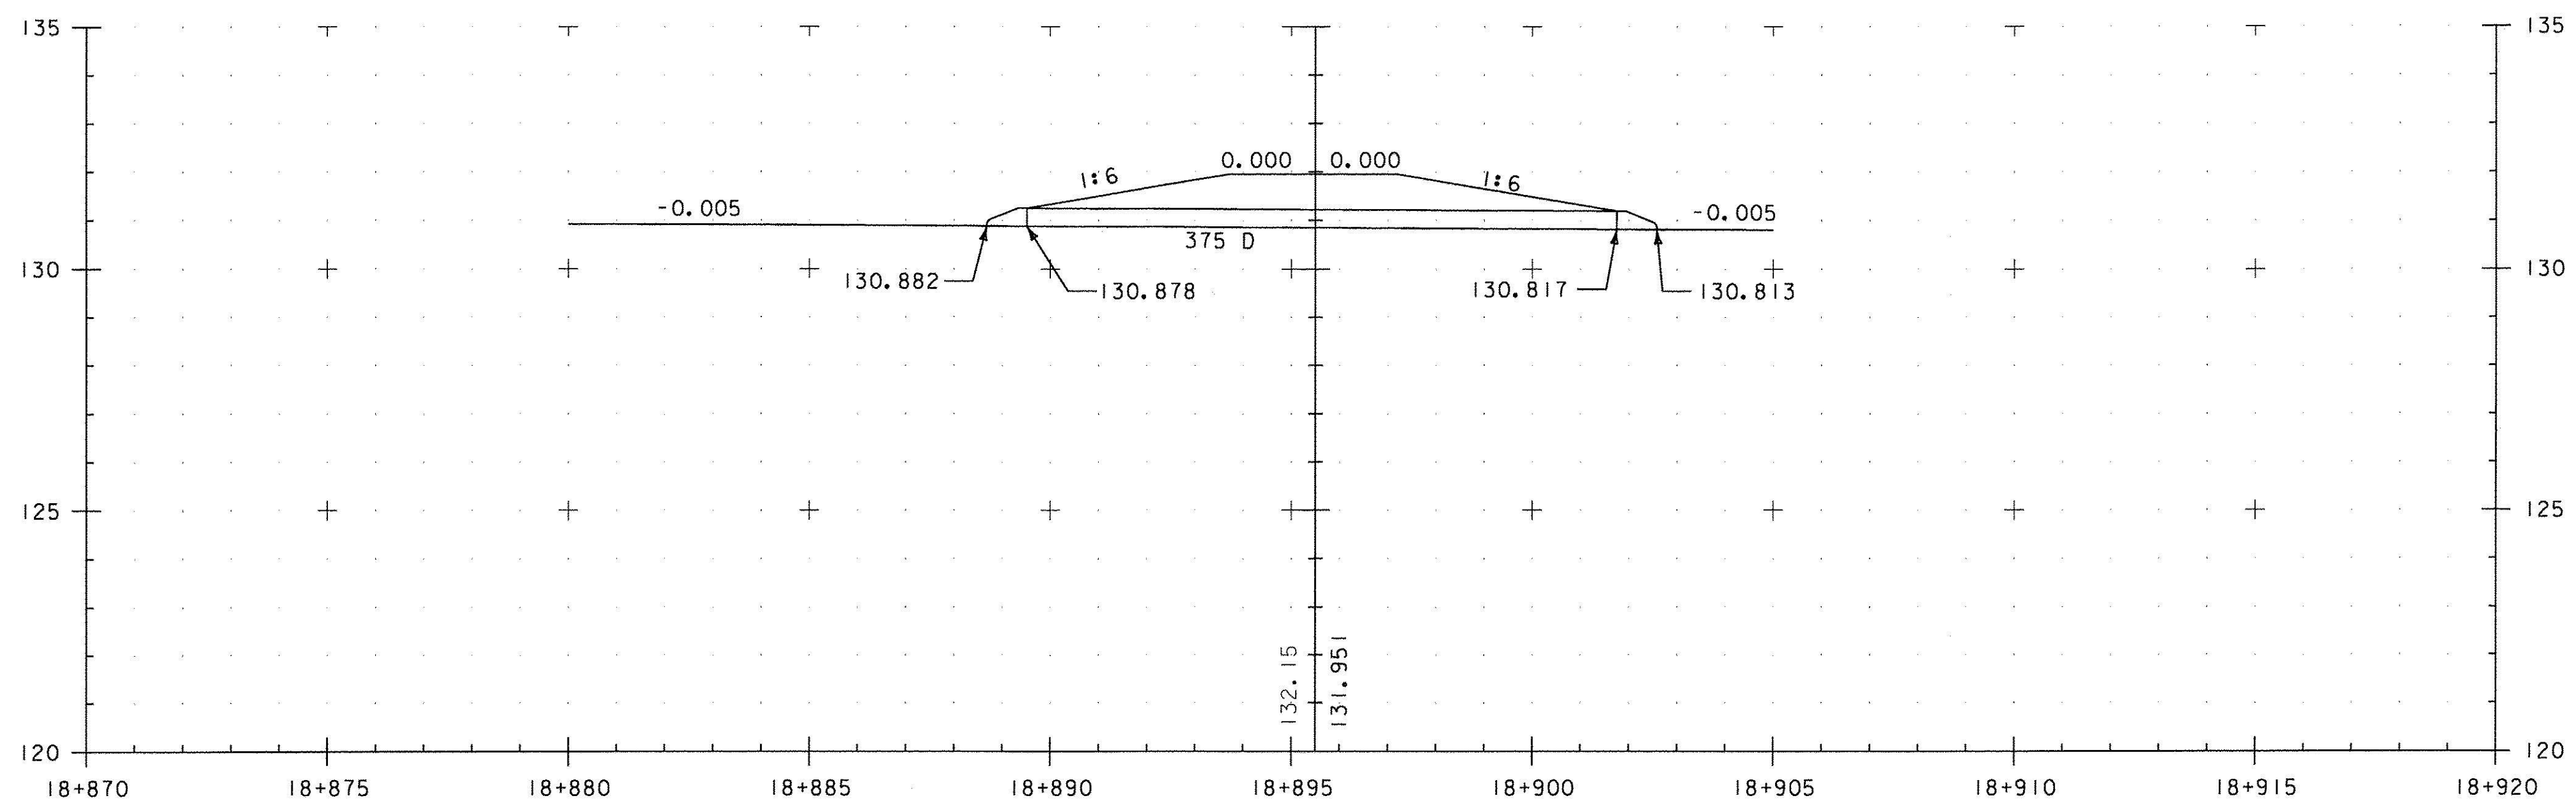

18+895.5  
DETAIL "A"

US 7

PROJECT NAME: BRANDON  
PROJECT NUMBER: NH 019-3(495)

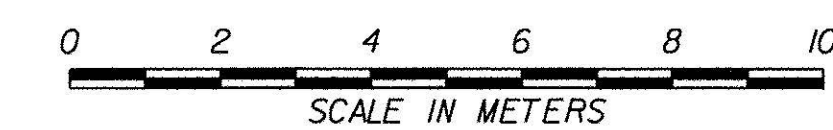

FILE NAME: zb008s5-xs090.dgn	PLOT DATE: 9/3/2009
PROJECT LEADER: CRB	DRAWN BY: NLL
DESIGNED BY: PTS	CHECKED BY: DAM
CLD 02-0149	SHEET 471 OF 546