


US 7

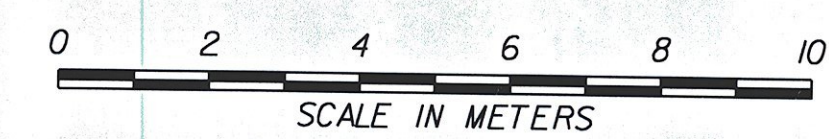

|                               |                     |
|-------------------------------|---------------------|
| PROJECT NAME: BRANDON         | PLOT DATE: 9/3/2009 |
| PROJECT NUMBER: NH 019-3(495) | DRAWN BY: NLL       |
| FILE NAME: zb008s5-xs203.dgn  | CHECKED BY: DAM     |
| PROJECT LEADER: CRB           | SHEET 474 OF 546    |
| DESIGNED BY: PTS              |                     |
| CLD 02-0149                   |                     |